

BILL OF MATERIALS			
ID	QTY	SCH/CLASS	DESCRIPTION
1	875 MM		TUBING, ASTM A269, SEAMLESS - 316SS
2	1		BEND 45 5R, TUBING, ASTM A269, 316SS
3	4		BEND 90 5R, TUBING, ASTM A269, 316SS
4	1		MaleStub1/2NPT(M) x 1/2"Tube
5	6		PRESSURE TRANSMITTER 1/2" NPT(M)
6	1		Male Connector 3/8 NPT x 1/2 T
7	1		ANGLE VALVE 3/8" NPT(M) X 3/8" NPT(F)
8	1		Female Union Elbow 1/2" T x 1/2 T


NOTES:
 1. ALL TAGS ARE LABELED AS FOLLOWS,
 PIT-RU0001(A/B)-01 WHERE 'A' STANDS FOR UNIT 1 &
 'B' STANDS FOR UNIT 2.
 FOR EXAMPLE:
 - PIT-RU0001A-01 FOR UNIT 1
 - PIT-RU0001B-01 FOR UNIT 2

Please add 2 way manifold (Both sides NPTF). it will be purchased from manual valve manufacturer. please add this manifold in part list


MME : NOTED, WILL BE REVISED ACCORDINGLY.

NPTM

MME: NOTED

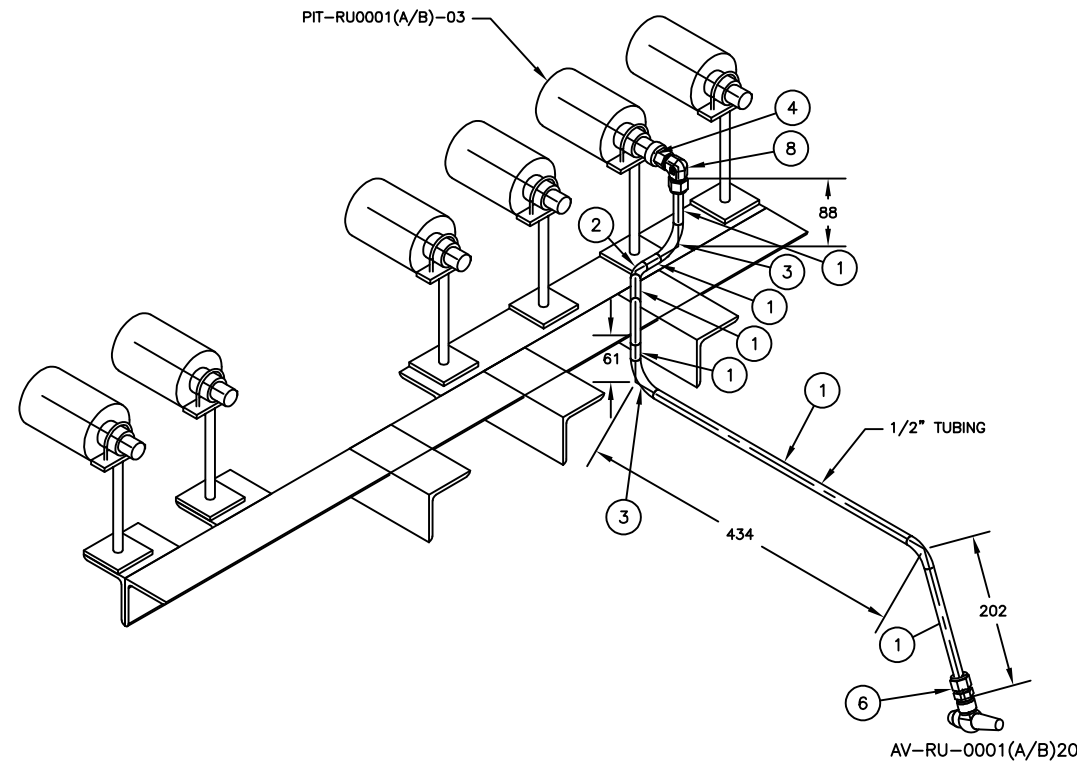

FOR DETAILED DWG OF SUPPORT, REFER DWG# PIT-RU0001A-SPRT

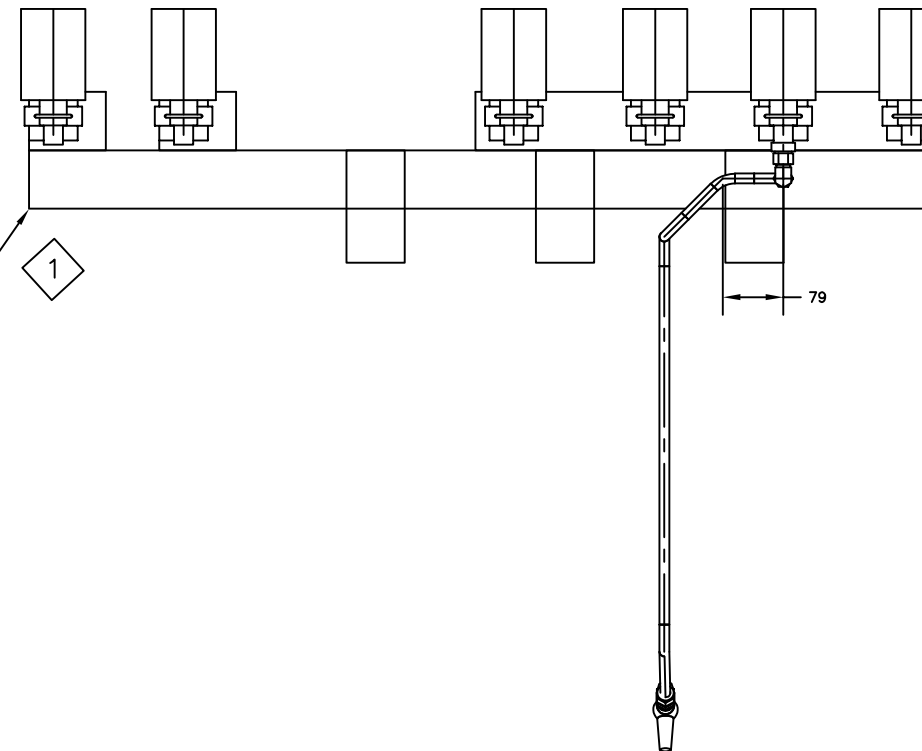

REV.	STATUS	DATE	PURPOSE OF ISSUE	PREP.	CHKD.	APPD.	AUTH.
0	F	15.08.24	FOR APPROVAL	AJD	AJD	IES	SES

CLIENT:	ENER TECHNOLOGI		
SERVICE:	PROPANE REFRIGERATION PACKAGE		
LOCATION:	IRAQ		
UNIT TAG NO.:	RU-0001 AB		
VENDOR LOGO			
Contract No.	P.O No. ENER-MME-2024-100-001		
SCALE			
DRAWING TITLE: PIT-RU0001(A/B)-03 HOOKUP DRAWING			
DRAWING NO. MPE007- PIT-RU0001(A/B)-03	REV. 0	SHEET No. 1 OF 1	SIZE D