
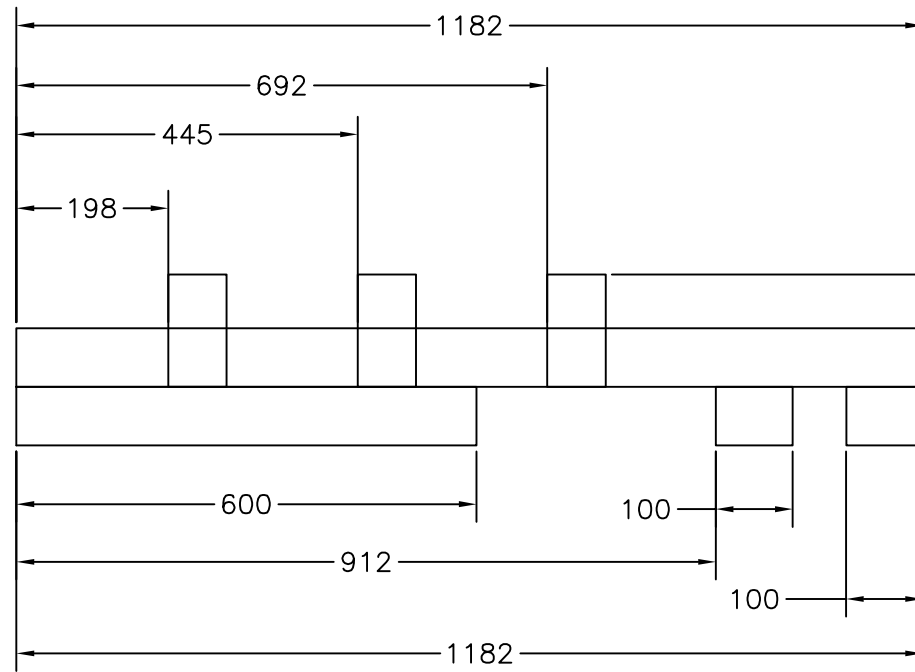


ANGLE SUPPORT 3 X 3 X 1/4

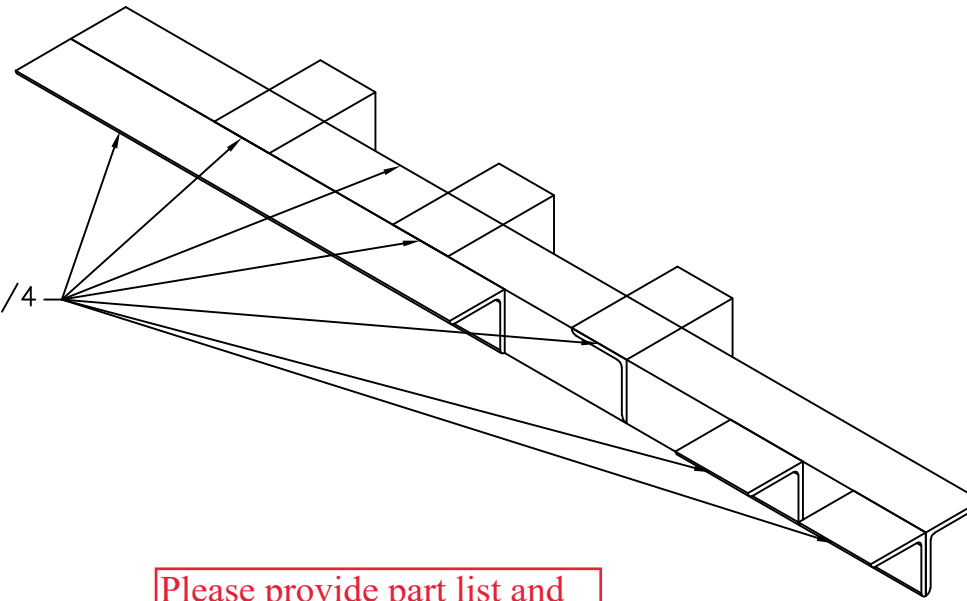


Please provide part list and Material

MME: BOM NOT REQUIRED AS THE IDENTIFYING LEADERS ARE SELF EXPLANATORY, AS ADVISED BY ISSAM. HOWEVER, IN ORDER TO ACCOMODATE THE MODIFICATIONS ADVISED WITH RESPECT TO THE ADDITION OF THE 2-WAY MANIFOLD, THIS SUPPORT DRAWING NEEDS TO BE UPDATED. THE REVISED DRAWING WILL BE FORWARDED SOON.

Please specify this dimension

MME : CLEARLY MENTIONED AS ANGLE SIZE 3" (76 MM).

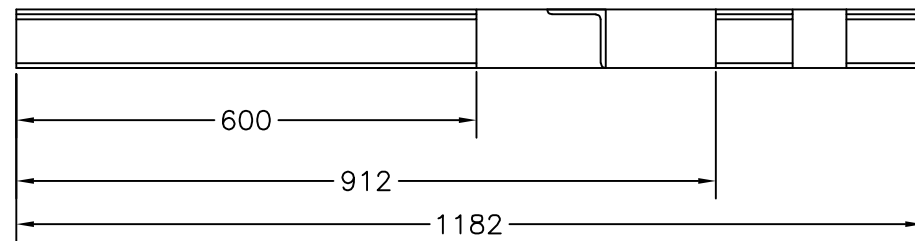

0	F	30.07.24	FOR APPROVAL	AJD	AJD	IES	SES
REV.	STATUS	DATE	PURPOSE OF ISSUE	PREP.	CHKD.	APPD.	AUTH.
<small>CLIENT: ENER TECHNOLOGI</small> <small>SERVICE: PROPANE REFRIGERATION PACKAGE</small> <small>LOCATION: IRAQ</small> <small>UNIT TAG NO.: RU-001 AB</small>							
<small>VENDOR LOGO</small>							
<small>Contract No.</small>		<small>P.O. No.</small> ENER-MME-2024-100-001		<small>SCALE</small>			
<small>DRAWING TITLE:</small> PRESSURE TRANSMITTER TUBING SUPPORT							
<small>DRAWING NO.</small> MPE007- PIT-RU0001A-SPRT				<small>REV.</small> 0	<small>SHEET No.</small> 1 OF 1	<small>SIZE</small> D	