


BILL OF MATERIALS			
ID	QTY	SCH/CLASS	DESCRIPTION
1	120 MM	80	PIPE, SEAMLESS, SCH80, PE, ASME B36.10, ASTM A333 Gr 6
2	1875 MM		TUBING, ASTM A269, SEAMLESS - 316SS
3	3		BEND 45 5R, TUBING, ASTM A269, 316SS
4	6		BEND 90 5R, TUBING, ASTM A269, 316SS
5	1	300	Y-Type Strainer, 3/8" ND, 300 LB, FPT, ASME B16.10
6	1		CV 3/8" NPT(F) x 3/8" NPT(F)
7	4		Male Connector 3/8 NPT x 3/8 T
8	1		ANGLE VALVE 3/8" NPT(M) X 3/8" NPT(F)
9	1	300	SIGHT GLASS, 3/8" NPT(F)
10	3		TUBE SUPPORT, 1/2"

NOTES:
 1. ALL TAGS ARE LABELED AS FOLLOWS,
 PIT-RU0001(A/B)-01 WHERE 'A' STANDS FOR UNIT 1 &
 'B' STANDS FOR UNIT 2.
 FOR EXAMPLE:
 - PIT-RU0001A-01 FOR UNIT 1
 - PIT-RU0001B-01 FOR UNIT 2

Needle Valve
 MME: NOTED

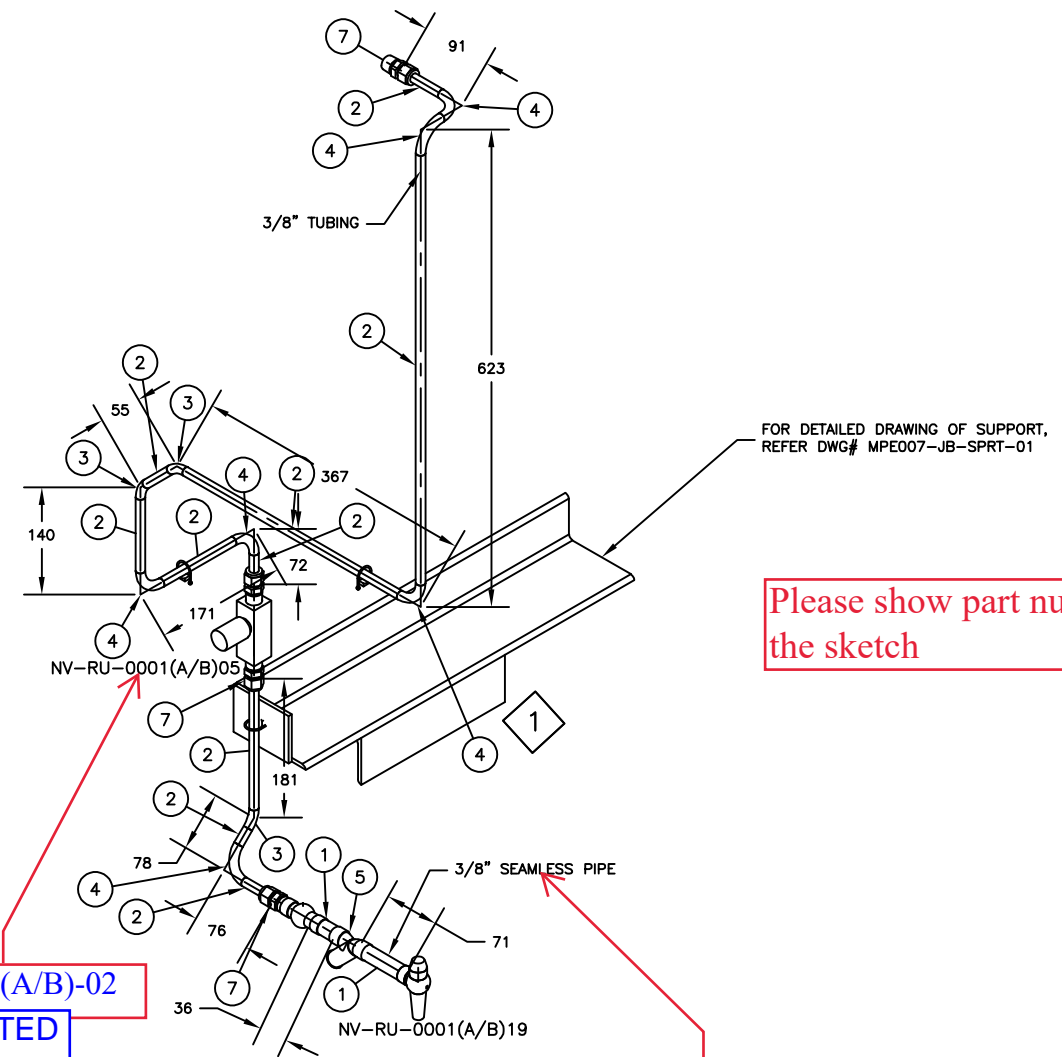

Please show part numbers 6,9,10 on the sketch
 MME: NOTED

NV-RU0001(A/B)-02
 MME: NOTED

Please recheck. based on PID, this is tubing

MME: AS PER LATEST COMMENTS, SECTION IDENTIFIED TO BE 3/8" PIPE. THE SAME WILL BE REFLECTED ON THE 3D MODEL.

0	F	16.08.24	FOR APPROVAL	AJD	AJD	IES	SES
REV.	STATUS	DATE	PURPOSE OF ISSUE	PREP.	CHKD.	APPD.	AUTH.
CLIENT: ENER TECHNOLOGI SERVICE: PROPANE REFRIGERATION PACKAGE LOCATION: IRAQ UNIT TAG NO.: RU-0001 AB							
VENDOR LOGO							
Contract No.		P.O. No. ENER-MME-2024-100-001		SCALE			
DRAWING TITLE: SEPARATOR OIL RECOVERY HOOKUP DRAWING							
DRAWING NO. MPE007- T0776				REV.	SHEET No.	SIZE	
				0	1 OF 1	D	