



 Gachsaran Polymer Industries Company	Gachsaran Polymer Industries Company HDPE Plant		
	General Arrangement Drawing (2D) (Tie-In Points , Skid Dimensions & Orientation, Including Instrument, Junction Box and Local Panel Location Layout & Instrument Cable routing.) for Refrigerator Package	 	
PO No.: GPIC-PT-MA-PO-000-3029	Document Number: VD-GPIC-MA-3029-3029-0062	Rev. 05	Page 1 of 12

General Arrangement Drawing (2D) (Tie-In Points , Skid Dimensions & Orientation, Including Instrument, Junction Box and Local Panel Location Layout & Instrument Cable routing.) for Refrigerator Package

Code1	<input type="checkbox"/> No Comment/ Approved (Applicable Only for "FOR REVIEW" and "For Approval" Documents) No comment and the document are released for Manufacturing.
Code2	<input type="checkbox"/> No Comment/ Approved with Note(s) Vendor/Sub-Contractor shall correct, revise and resubmit the document. The document is released for Manufacturing if changes incorporated.
Code3	<input checked="" type="checkbox"/> Commented Vendor/Sub-Contractor shall correct, revise and resubmit the document by the date specified. The document shall be revised under the Status of "R: Revised Issue". All corrected documents shall be resubmitted before starting the Manufacturing Process.
	<input type="checkbox"/> Not Accepted (Rejected) Vendor/Sub-Contractor shall re-work / re-design / re-specify the contents of the document according to
PI COMMENT: (REPEATED COMMENT) -Since location some of TI-IN's (S-41, S-42, S-43, S-44, S-31) are inside package and the direct connection of some lines may cause clashes with the lines and equipments inside the package so the TI in/out should be specified in boundary skids.	
Document has been submitted for PURCHASER's Information (FI). Consistency, completeness and correctness of document content is in Vendor/Sub-Contractor's responsibility.	
Above checking results by EIED shall in no way relieve Vendor of any liability, obligation and responsibility out of the purchase order and the mutual agreement in writing.	
 Energy Industries Engineering & Design co.	Date: April.26, 2026 Dept.: MA Signature: F.Hamooni

MA-G0:
 Generally this document could be considered as code-2, but The above comment of Piping department should be considered as EIED's concern on this matter. if vendor requires a meeting, it could be arranged by vendor's request.

			A.M	A.M	F.T
			A.M	A.M	F.T
			A.M	A.M	F.T
02	9-Oct-25	IFR	N.B	A.M	F.T
01	16-Sep-25	IFR	A.M	A.M	F.T
00	28-Jun-25	IFR	A.M	A.M	F.T
Rev.	DATE	PURPOSE OF ISSUE	PREPARED	CHECKED	APPROVED

NORTH



PI COMMENT: (REPEATED COMMENT)
-Since location some of TI-IN's (S-41, S-42, S-43, S-44, S-31) are inside package and the direct connection of some lines may cause clashes with the lines and equipments inside the package so the TI in/out should be specified in boundary skids.

General:
-Please note that related foundation has been constructed based on the attached drawing.
-Foundation location plan will be checked and commented based on the AFC foundation drawing in the document No.VD-GPIC-MA-3029-3029-0071 (Skid Foundation Plan (Foundation Loading Data) for Refrigerator Package)

Please check equipment Tag Nos (for example: drum with tag No D-6101 is located on the STR-P03)

- NOTES:
- FOR OPERATING AND DRY WEIGHTS, REFER TO ULT003-50098.
 - FOR CENTER OF GRAVITY, REFER TO ULT003-50098.
 - FOR DYNAMIC AND STATIC LOADS, REFER TO ULT003-50098.
 - FOR FOUNDATION DETAIL DRAWING, REFER TO ULT003-20021.
 - FOR LIFTING DETAILS, REFER TO ULT003-20011A.
 - FOR SKID INSTALLATION, REFER TO INSTRUCTION AND OPERATIONAL MANUAL ULT003-20092.
 - DIMENSIONS ARE IN INCHES AND MM IN PARENTHESIS.
 - ANCHOR HOLES TOLERANCES ± 0.13 in (± 3.2 mm).
 - BEAM LOCATION TOLERANCES: ± 0.13 in (± 3.2 mm).
 - NON-SKID GRATING UNDER MAINTENANCE AREA IS NOT INCLUDED.
 - SKID FLATNESS SHALL BE 0.0625" (1.6 mm).
 - SURFACE PREPARATION SHALL BE PER PROJECT PAINTING SPECIFICATION.
 - ANCHOR BOLT HOLES SHALL BE WITHIN THE SAME XY AND XZ PLANES WITHIN ± 0.13 in (± 3.2 mm).
 - COMPRESSOR SKIDS SHALL BE GROUTED. GROUT SPECIFICATION AND SELECTION BY OTHER AND SHALL BE SUITABLE TO PAINTING APPLICATION.
 - FOR PIPE NOZZLE LOADS REFER TO DOCUMENT NUMBER VD-GPIC-MA-3029-3029-0062-G (ULT003-20011G)

Code1	<input type="checkbox"/> No Comment/ Approved (Applicable Only for "FOR REVIEW" and "For Approval" Documents) No comment and the document are released for Manufacturing
Code2	<input type="checkbox"/> No Comment / Approved with Note(s) Vendor/Sub-Contractor shall correct, revise and resubmit the document. The document is released for Manufacturing if changes incorporated.
Code3	<input type="checkbox"/> Commented Vendor/Sub-Contractor shall correct, revise and resubmit the document by the date specified. The document shall be raised under the Status of "R: Revised Issue". All corrected documents shall be resubmitted before starting the Manufacturing Process
Code4	<input type="checkbox"/> Not Accepted (Rejected) Vendor/Sub-Contractor shall re-work/re-design/re-specify the contents of the document according to the comments/reasons for rejection. All corrected documents shall be resubmitted before starting the manufacturing. Vendor/Sub-Contractor shall not proceed with subsequent works of Material Supply or Manufacturing until receiving Code1/Code2 or No Code from PURCHASER. Vendor/Sub-Contractor shall resubmit the document with the same revision within 6 working days after receiving comments
No Code	<input type="checkbox"/> No Code (Only for "For Information" Documents and "As Built DWGs") Document has been submitted for PURCHASER's Information (I). Considering completeness and correctness of document content is in Vendor/Sub-Contractor's responsibility.

The above checking result by EIED shall in no way relieve Vendor of any liability, obligation and responsibility out of the purchase order and the mutual agreement in writing.

EIED

DATE :
DEPT :
Signature :

CV	PI	EL	IN	ME	MA
ST	BU	PR	SA	HW	TL

05	23.02.2026	IFR	FA	IM	OG
04	20.12.2025	IFR	FA	IM	OG
03	05.11.2025	IFR	FA	IM	OG
02	09.10.2025	IFR	FA	IM	OG
01	16.09.2025	IFR	FA	IM	OG
00	28.06.2025	IFR	FA	IM	OG
REV.	DATE (DD.MM.YY)	Purpose of Issue	Prepared	Checked	Approved

GPI Sachsan Polymer Industries Company

HDPE Plant

EIED


DELTA PROCESS EQUIPMENT


PO No.: GPIC-PT-MA-PO-000-3029

SCALE: 3/8":1'


DRAWING TITLE: **GENERAL ARRANGEMENT DRAWING**

DRAWING NO.	VD-GPIC-MA-3029-3029-0062	REV.	SHEET NO.	SIZE
		05	3 OF 12	A1

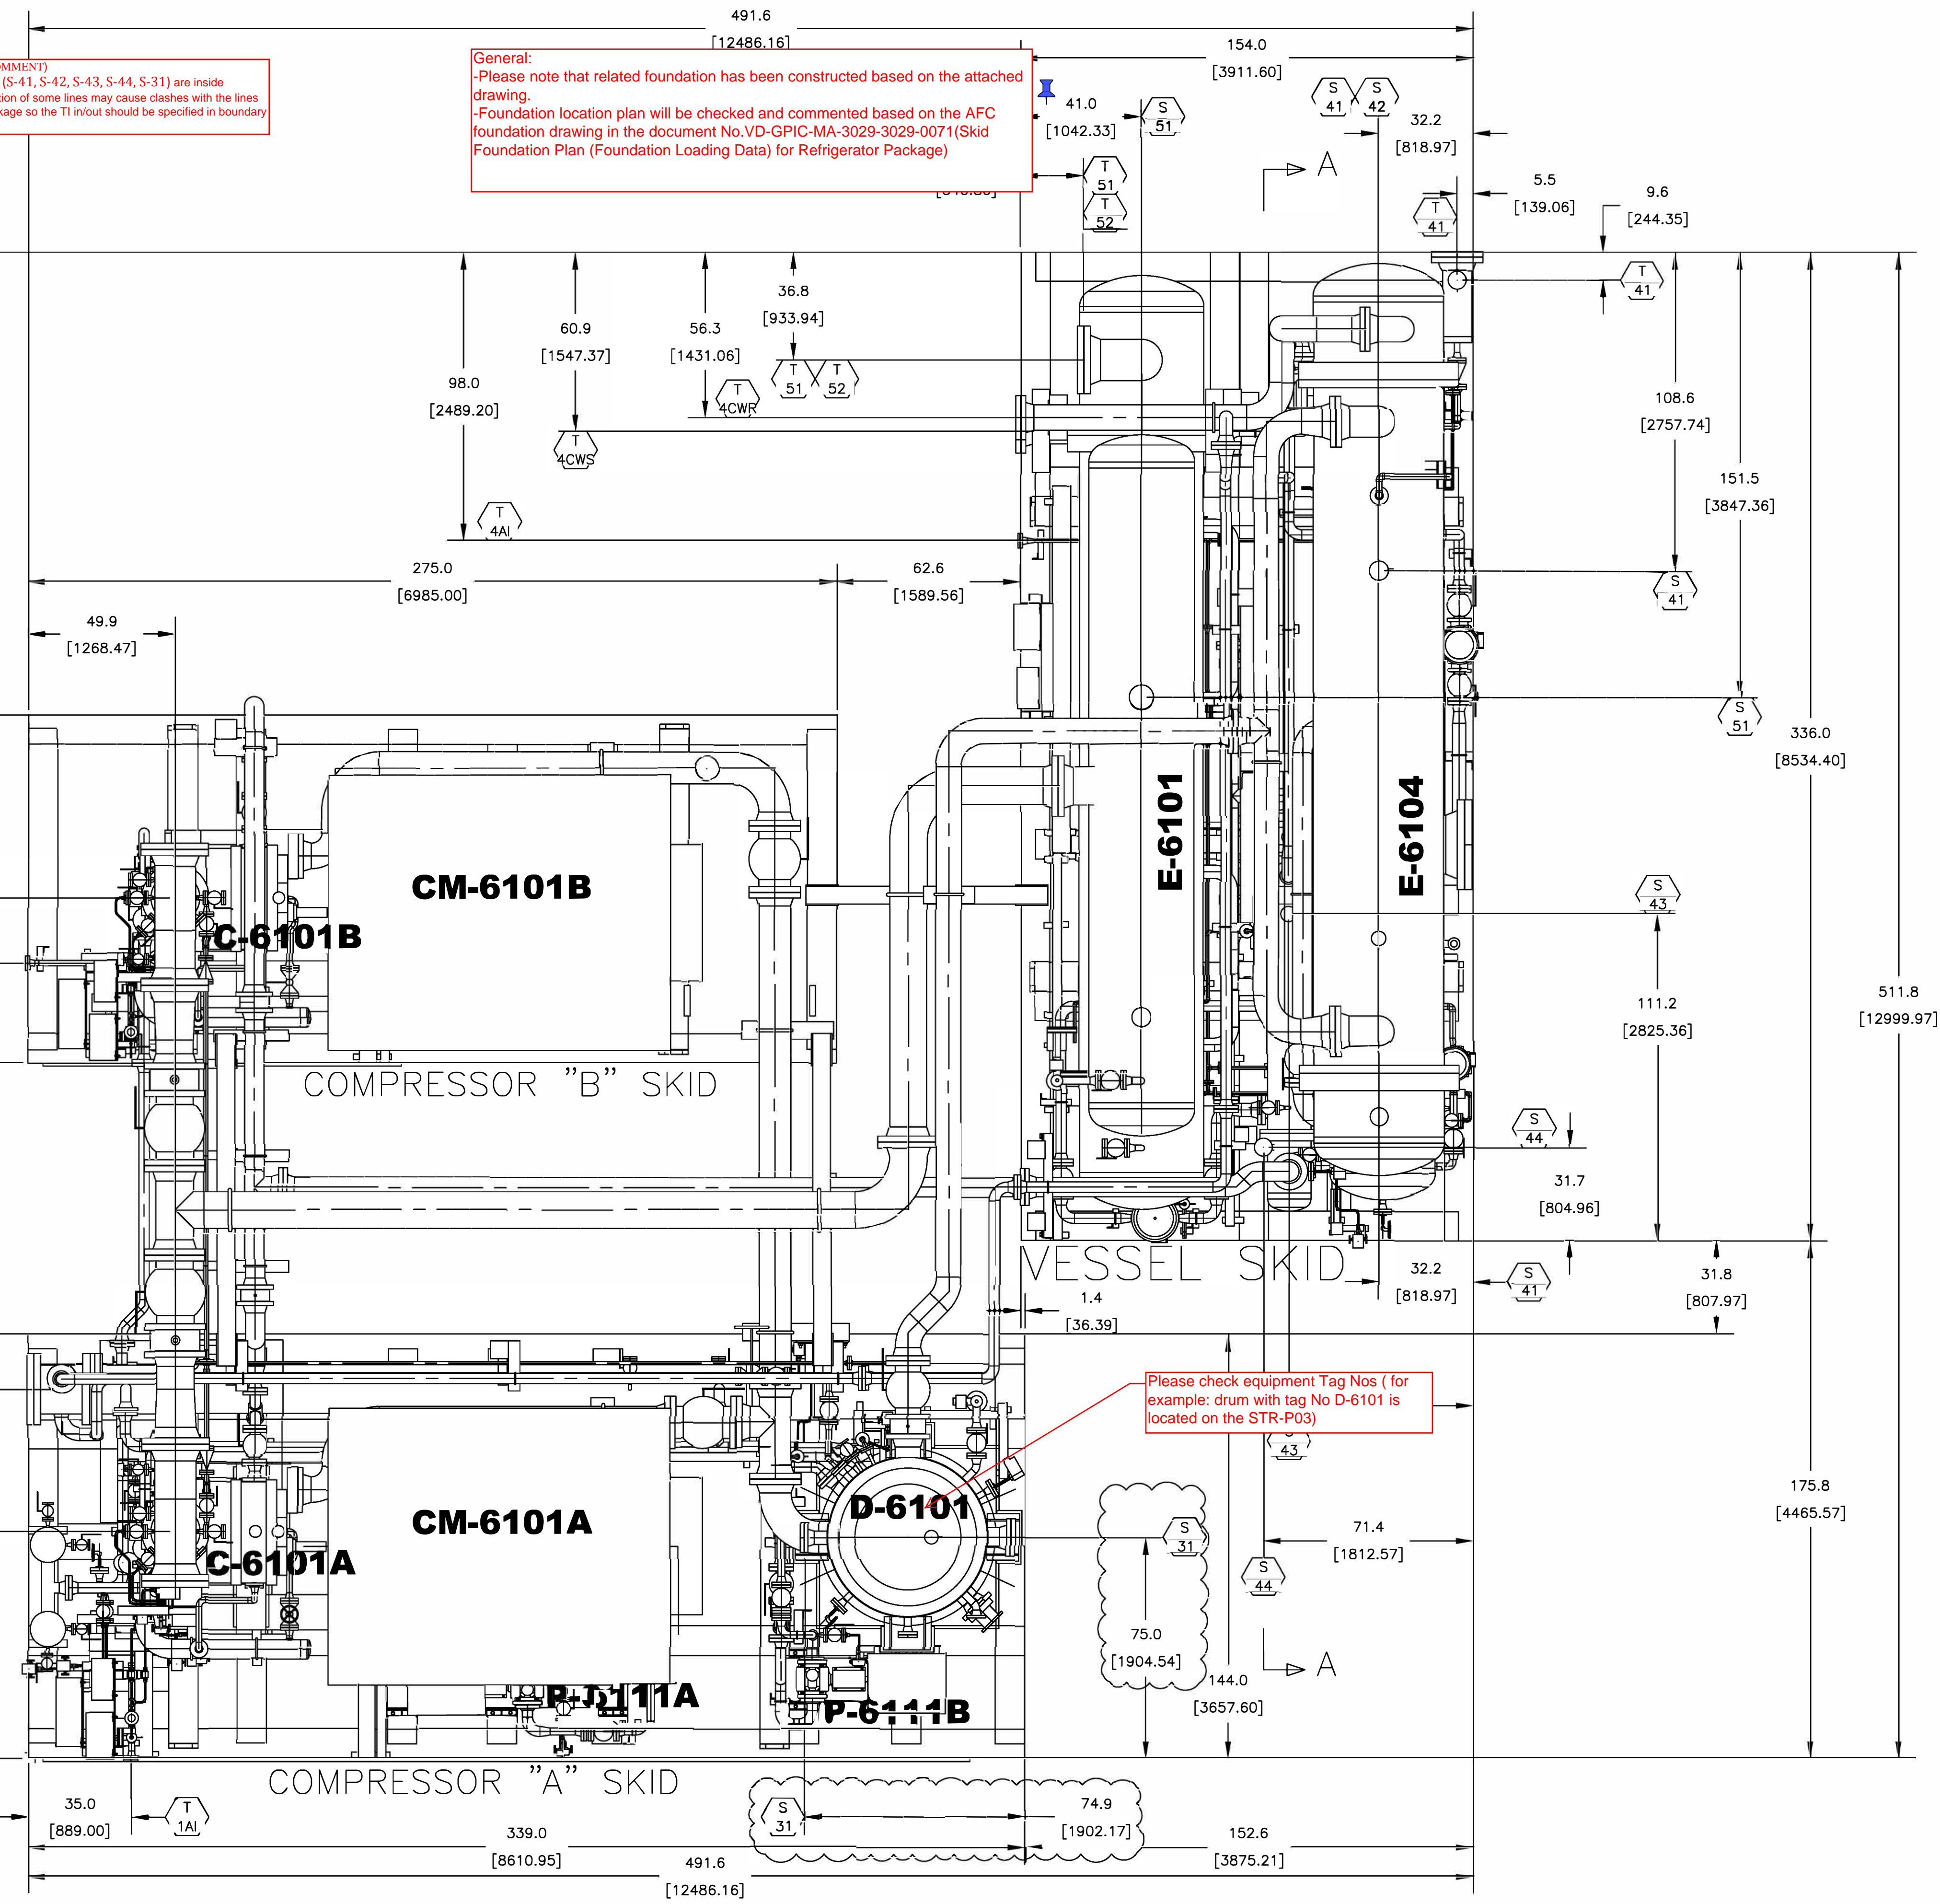

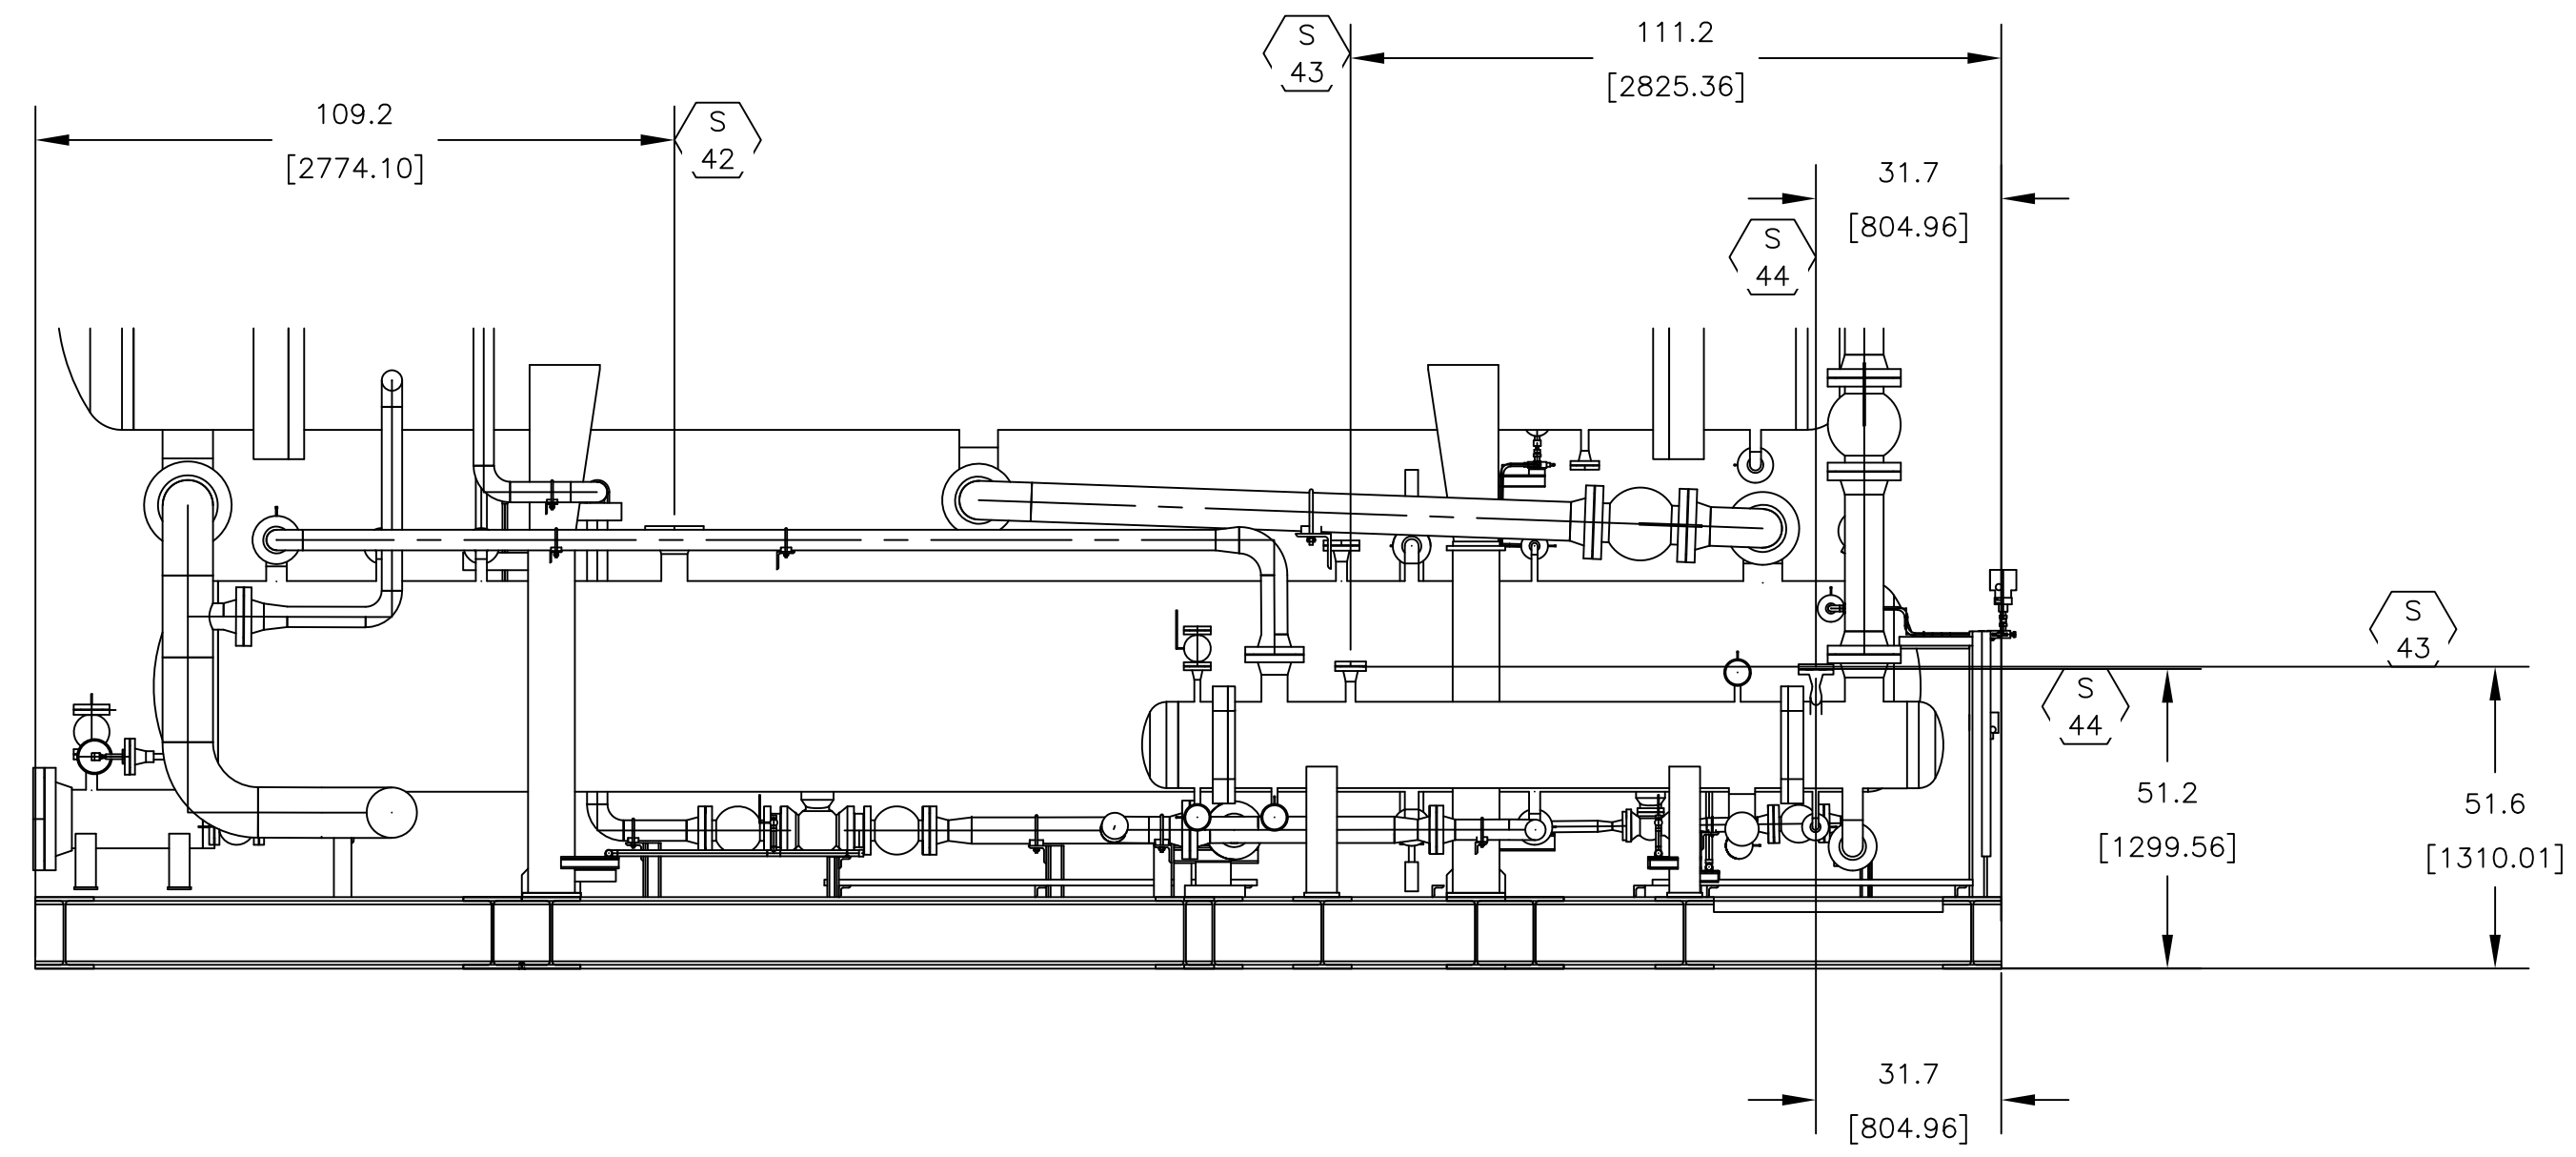

SECTION A - A

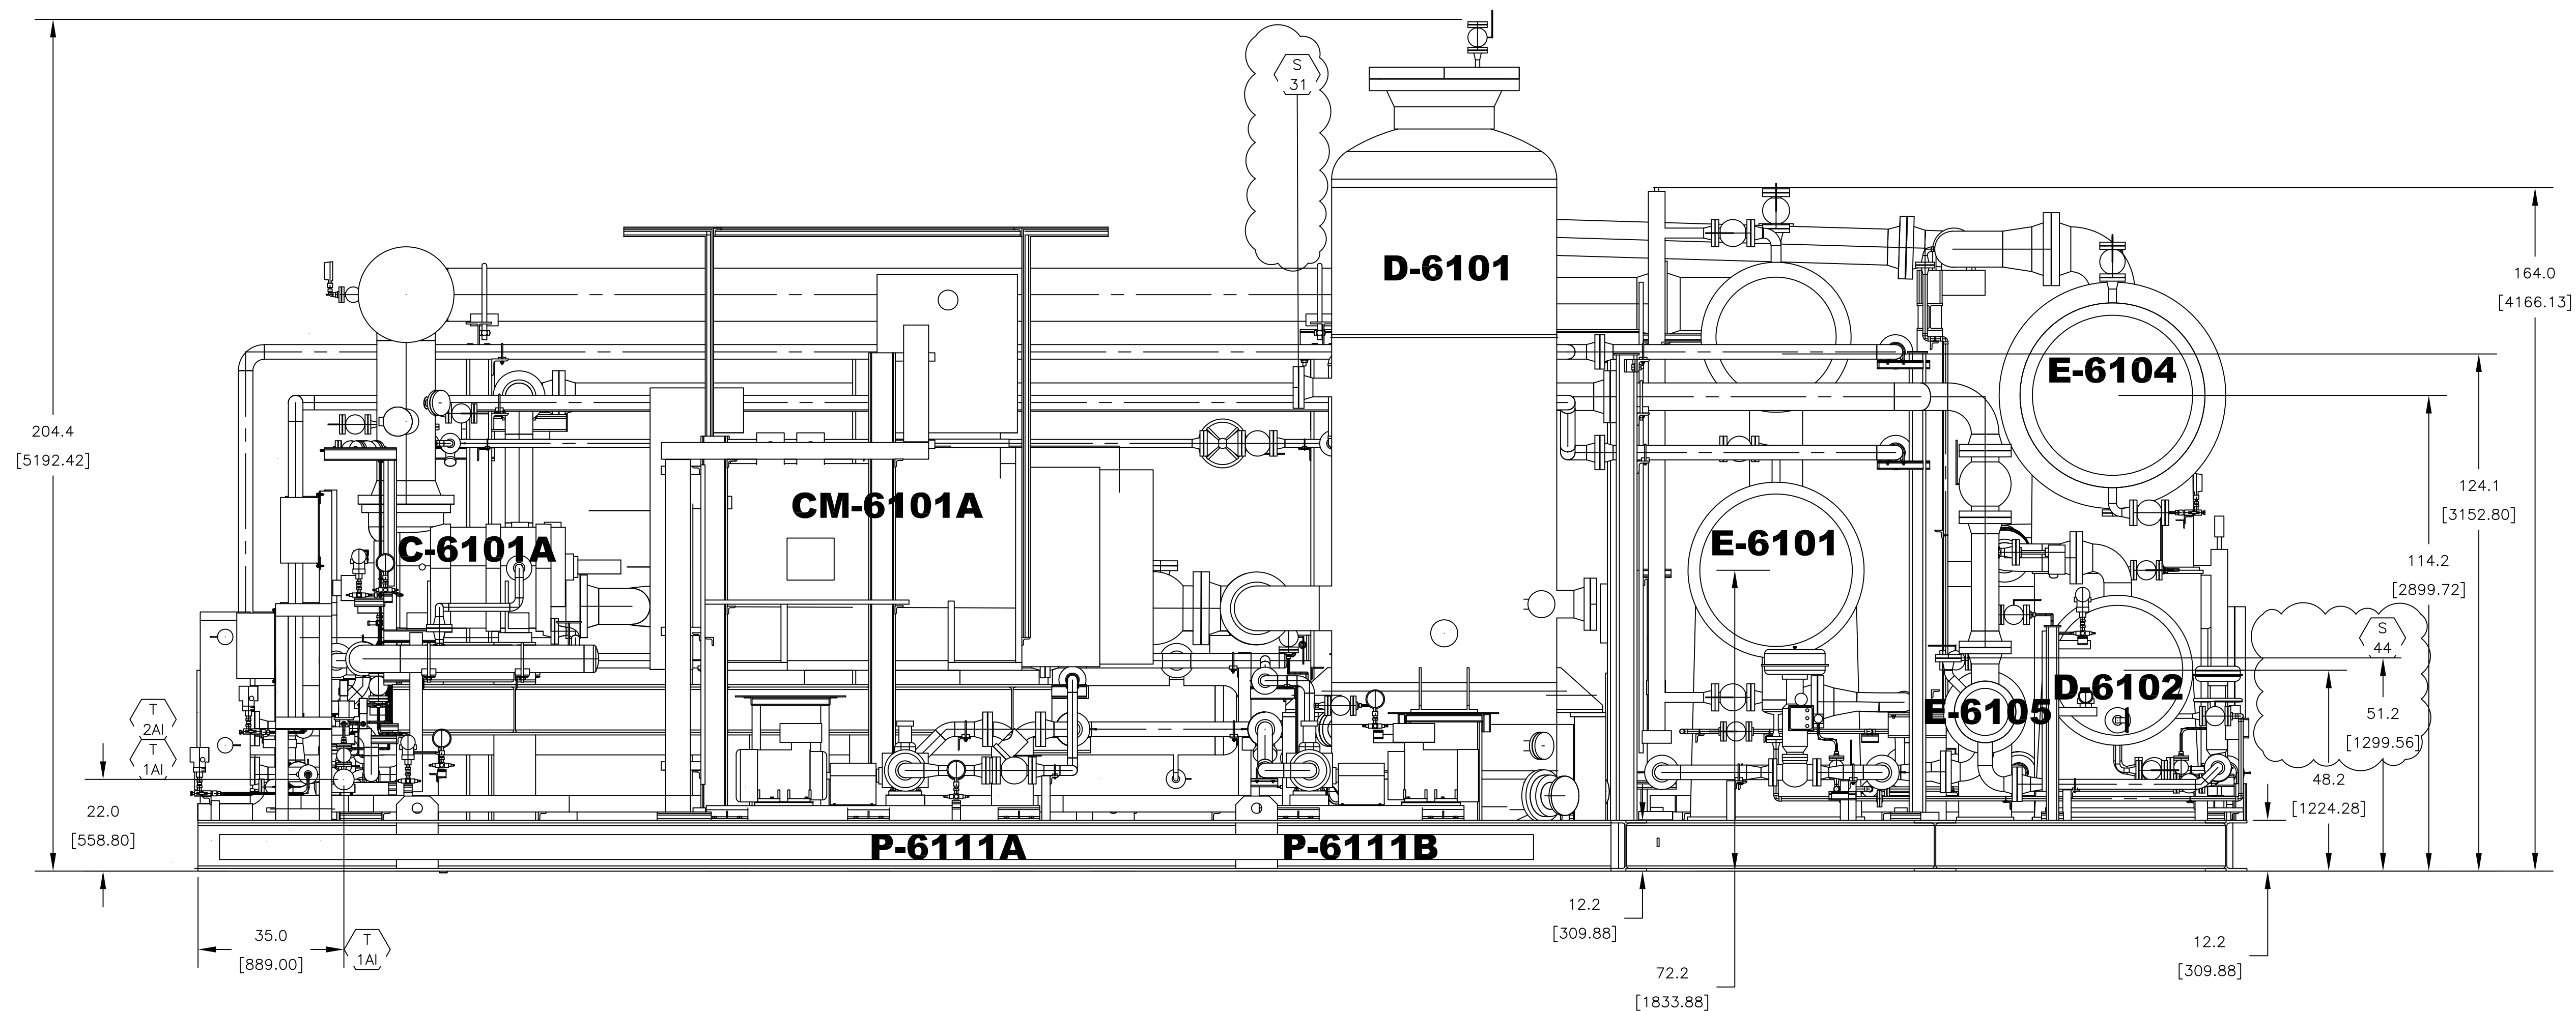

FRONT VIEW

Code1	<input type="checkbox"/> No Comment/ Approved (Applicable Only for "FOR REVIEW" and "For Approval" Documents) No comment and the document are released for Manufacturing
Code2	<input type="checkbox"/> No Comment / Approved with Note(s) Vendor/Sub-Contractor shall correct, revise and resubmit the document. The document is released for Manufacturing if changes incorporated.
Code3	<input type="checkbox"/> Commented Vendor/Sub-Contractor shall correct, revise and resubmit the document by the date specified. The document shall be revised under the Status of "R: Revised Issue". All corrected documents shall be resubmitted before starting the Manufacturing Process
Code4	<input type="checkbox"/> Not Accepted (Rejected) Vendor/Sub-Contractor shall re-work/re-design/re-specify the contents of the document according to the comments/reasons for rejection. All corrected documents shall be resubmitted before starting the manufacturing. Vendor/Sub-Contractor shall not proceed with subsequent works of Material Supply or Manufacturing until receiving Code1/Code2 or No Code from PURCHASER. Vendor/Sub-Contractor shall resubmit the document with the same revision within 6 working days after receiving comments
No Code	<input type="checkbox"/> No Code (Only for "For Information" Documents and "As Built DWG") Document has been submitted for PURCHASER'S information (If) Consistency, completeness and correctness of document content is in Vendor/Sub-Contractor's responsibility.



The above checking result by EIED shall in no way relieve Vendor of any liability, obligation and responsibility out of the purchase order and the mutual agreement in writing



DATE :
DEPT :
Signature :
EIED

CV	PI	EL	IN	ME	MA
ST	BU	PR	SA	HV	TL

05	23.02.2026	IFR	FA	IM	OG
04	20.12.2025	IFR	FA	IM	OG
03	05.11.2025	IFR	FA	IM	OG
02	09.10.2025	IFR	FA	IM	OG
01	16.09.2025	IFR	FA	IM	OG
00	28.06.2025	IFR	FA	IM	OG

REV.	DATE (DD.MM.YY)	Purpose of Issue	Prepared	Checked	Approved
------	-----------------	------------------	----------	---------	----------



Gachsan Polymer Industries Company
HDPE Plant


PO No.: GPIC-PT-MA-PO-000-3029 SCALE: 1/2":1'

DRAWING TITLE: **GENERAL ARRANGEMENT DRAWING**

DRAWING NO.	REV.	SHEET NO.	SIZE
VD-GPIC-MA-3029-3029-0062	05	4 of 12	A1



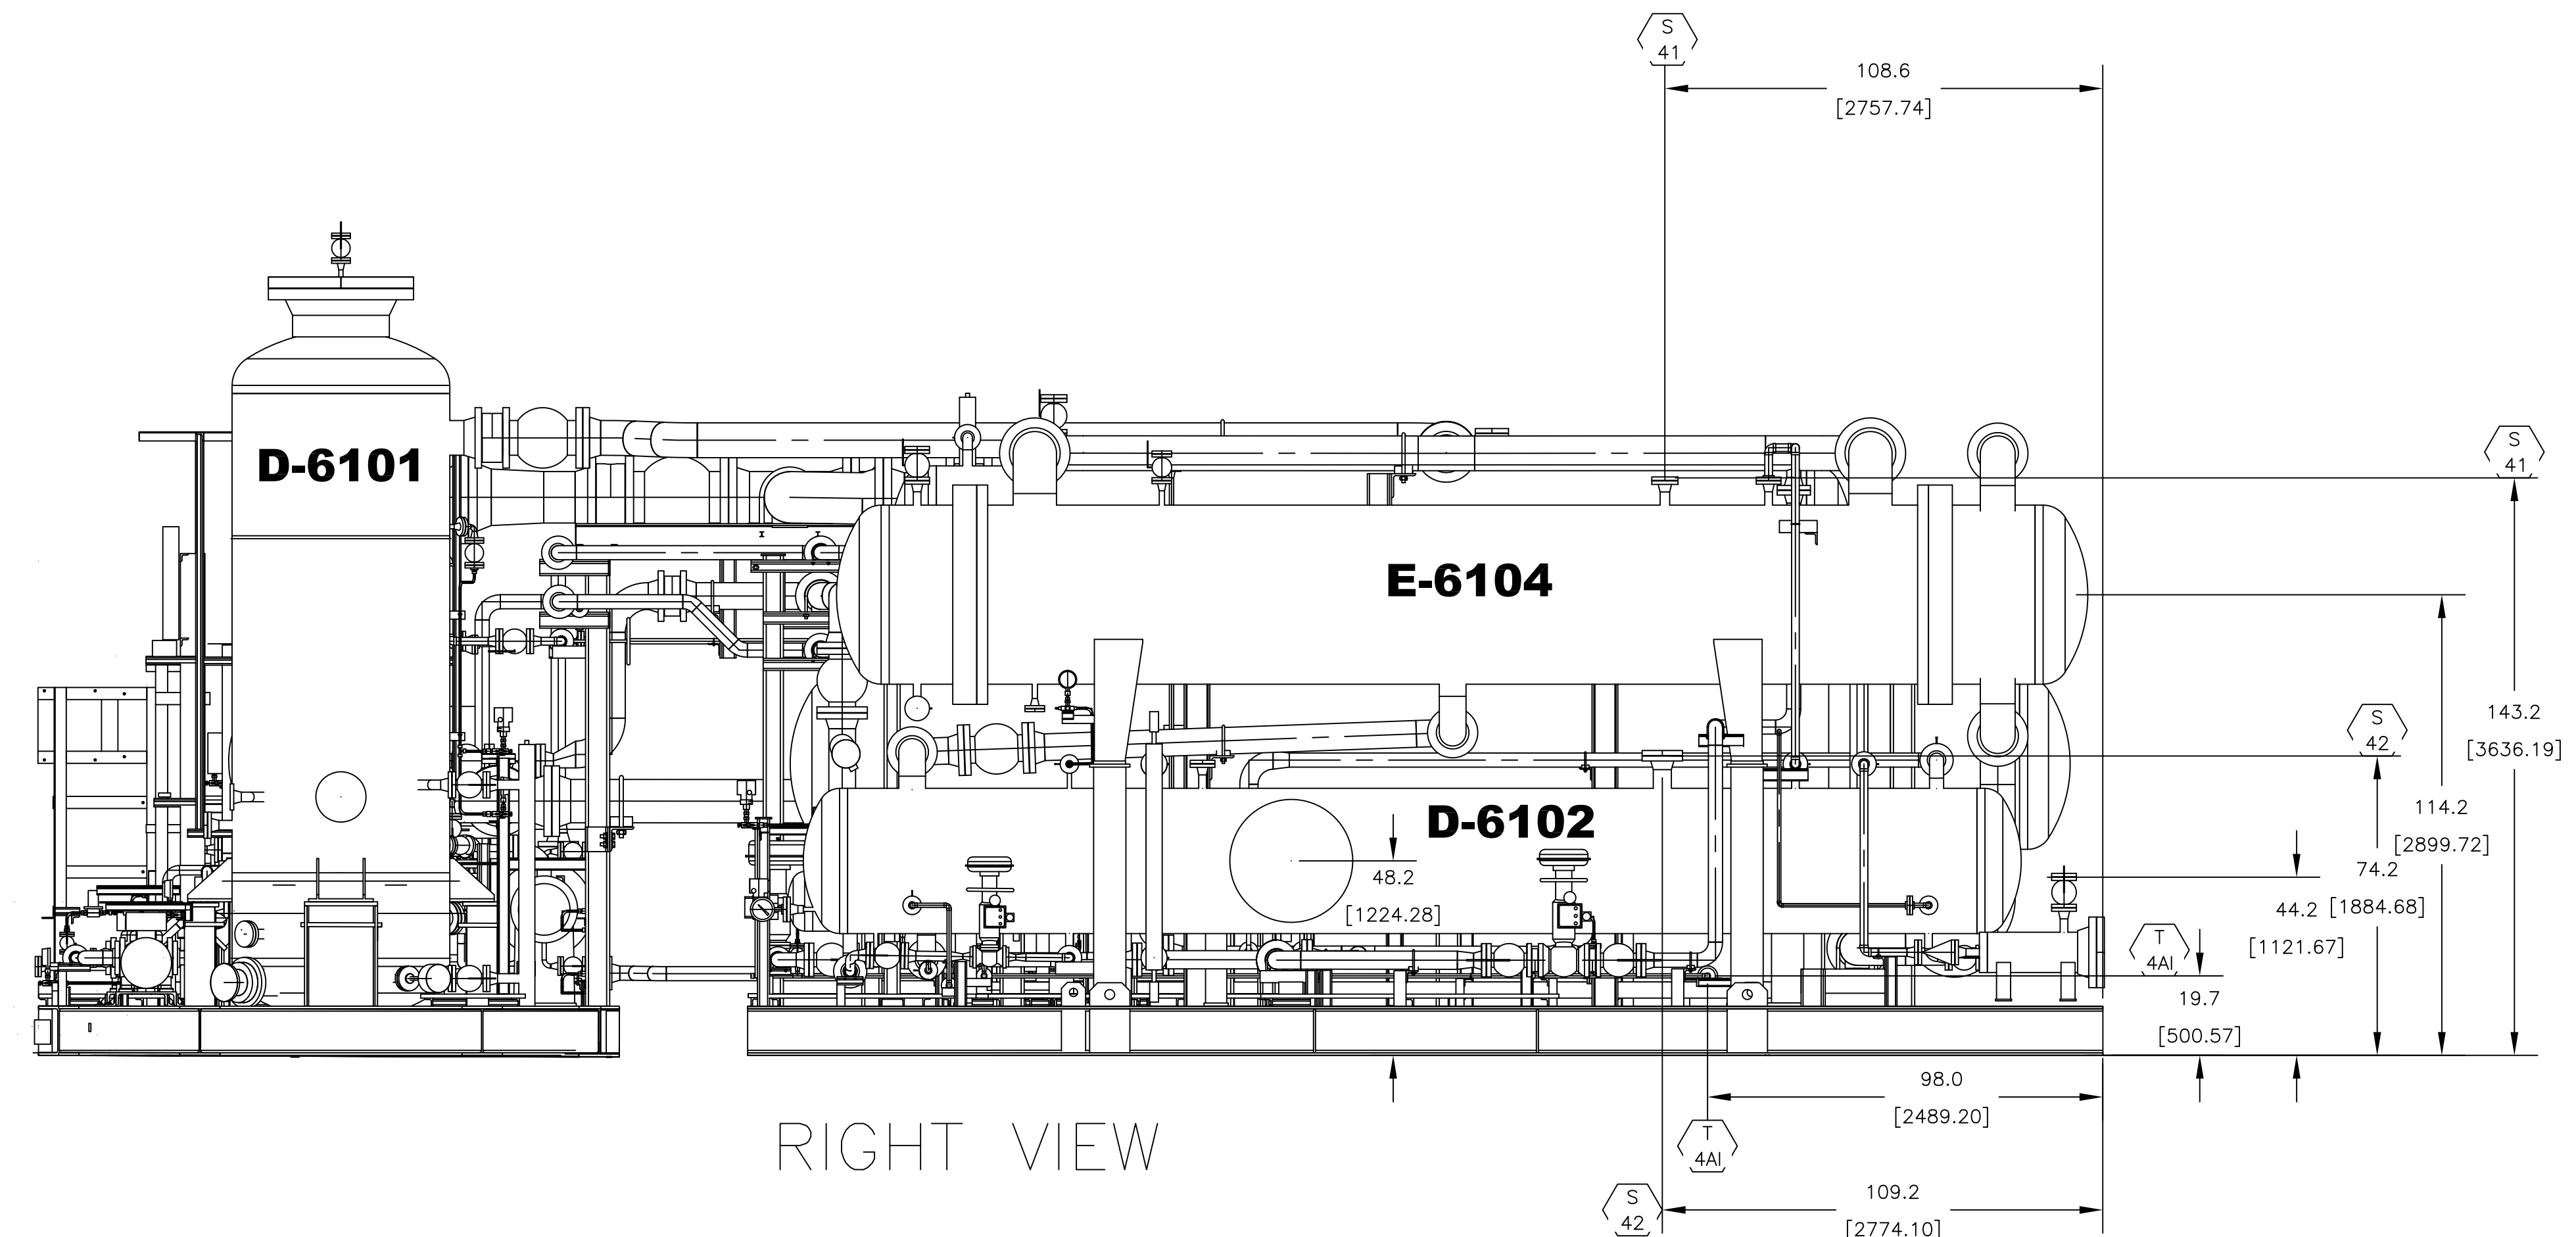

CONNECTION LIST			
NO.	LOCATION	DESCRIPTION	SIZE
T-1AI	COMPRESSOR SKID-A	INSTRUMENT AIR SUPPLY	1"-300 ANSI RF
T-2AI	COMPRESSOR SKID-B	INSTRUMENT AIR SUPPLY	1"-300 ANSI RF
T-4AI	VESSEL SKID	INSTRUMENT AIR SUPPLY	1"-300 ANSI RF
T-4CWS	VESSEL SKID	OIL COOLER COOLING WATER SUPPLY	8"-300 ANSI RF
T-4CWR	VESSEL SKID	OIL COOLER COOLING WATER RETURN	8"-300 ANSI RF
T-41	VESSEL SKID	FILTER/DRYER INLET	1-1/2"-300 ANSI RF
T-51	VESSEL SKID	CHILLER PROCESS INLET	14"-300 ANSI RF
T-52	VESSEL SKID	CHILLER PROCESS OUTLET	14"-300 ANSI RF
S-31	COMPRESSOR SKID-A	OIL SEPARATOR PRESSURE SAFETY	4"-300 ANSI RF
S-41	VESSEL SKID	CONDENSER PRESSURE SAFETY	3"-300 ANSI RF
S-42	VESSEL SKID	RECEIVER PRESSURE SAFETY	4"-300 ANSI RF
S-43	VESSEL SKID	ECONOMIZER PRESSURE SAFETY-SHELL	1-1/2"-300 ANSI RF
S-44	VESSEL SKID	ECONOMIZER PRESSURE SAFETY-TUBE	1-1/2"-300 ANSI RF
S-51	VESSEL SKID	CHILLER PRESSURE SAFETY	3"-300 ANSI RF

EQUIPMENT TAG NUMBER	
TAG NO.	DESCRIPTION
C-6101A	COMPRESSOR
C-6101B	COMPRESSOR
CM-6101A	COMPRESSOR MOTOR
CM-6101B	COMPRESSOR MOTOR
E-6101	CHILLER
E-6102	OIL COOLER
E-6104	CONDENSER
E-6105	ECONOMIZER
D-6101	OIL SEPARATOR
D-6102	RECEIVER
P-6111A/A	OIL PUMPS
PM-6111A/A	OIL PUMP MOTORS
F-6102	FILTER/DRYER
F-6101A/B	OIL FILTER



Code1	<input type="checkbox"/> No Comment/ Approved (Applicable Only for "FOR REVIEW" and "For Approval" Documents) No comment and the document are released for Manufacturing				
Code2	<input type="checkbox"/> No Comment / Approved with Note(s) Vendor/Sub-Contractor shall correct, revise and resubmit the document. The document is released for Manufacturing if changes incorporated.				
Code3	<input type="checkbox"/> Commented Vendor/Sub-Contractor shall correct, revise and resubmit the document by the date specified. The document shall be revised under the Status of "R: Revised Issue". All corrected documents shall be resubmitted before starting the Manufacturing Process				
Code4	<input type="checkbox"/> Not Accepted (Rejected) Vendor/Sub-Contractor shall re-work/re-design/re-specify the contents of the document according to the comments/reasons for rejection. All corrected documents shall be resubmitted before starting the manufacturing. Vendor/Sub-Contractor shall not proceed with subsequent works of Material Supply or Manufacturing unit receiving Code1/Code2 or No Code from PURCHASER. Vendor/Sub-Contractor shall resubmit the document with the same revision within 6 working days after receiving comments				
No Code	<input type="checkbox"/> No Code (Only for "For Information" Documents and "As Built DWGs") Document has been submitted for PURCHASER'S information (If). Considering completeness and correctness of document content is in Vendor/Sub-Contractor's responsibility.				
The above checking result by EED shall in no way relieve Vendor of any liability, obligation and responsibility out of the purchase order and the mutual agreement in writing.					
DATE : DEPT : Signature :					
CV	PI	EL	IN	ME	MA
ST	BU	PR	SA	HY	TL

REV.	DATE (DD.MM.YY)	Purpose of Issue	Prepared	Checked	Approved
05	23.02.2026	IFR	FA	IM	OG
04	20.12.2025	IFR	FA	IM	OG
03	05.11.2025	IFR	FA	IM	OG
02	09.10.2025	IFR	FA	IM	OG
01	16.09.2025	IFR	FA	IM	OG
00	28.06.2025	IFR	FA	IM	OG







Gachsaran Polymer Industries Company
HDPE Plant


PO No.: GPIC-PT-MA-PO-000-3029 SCALE: 1/2":1'

DRAWING TITLE: **GENERAL ARRANGEMENT DRAWING**

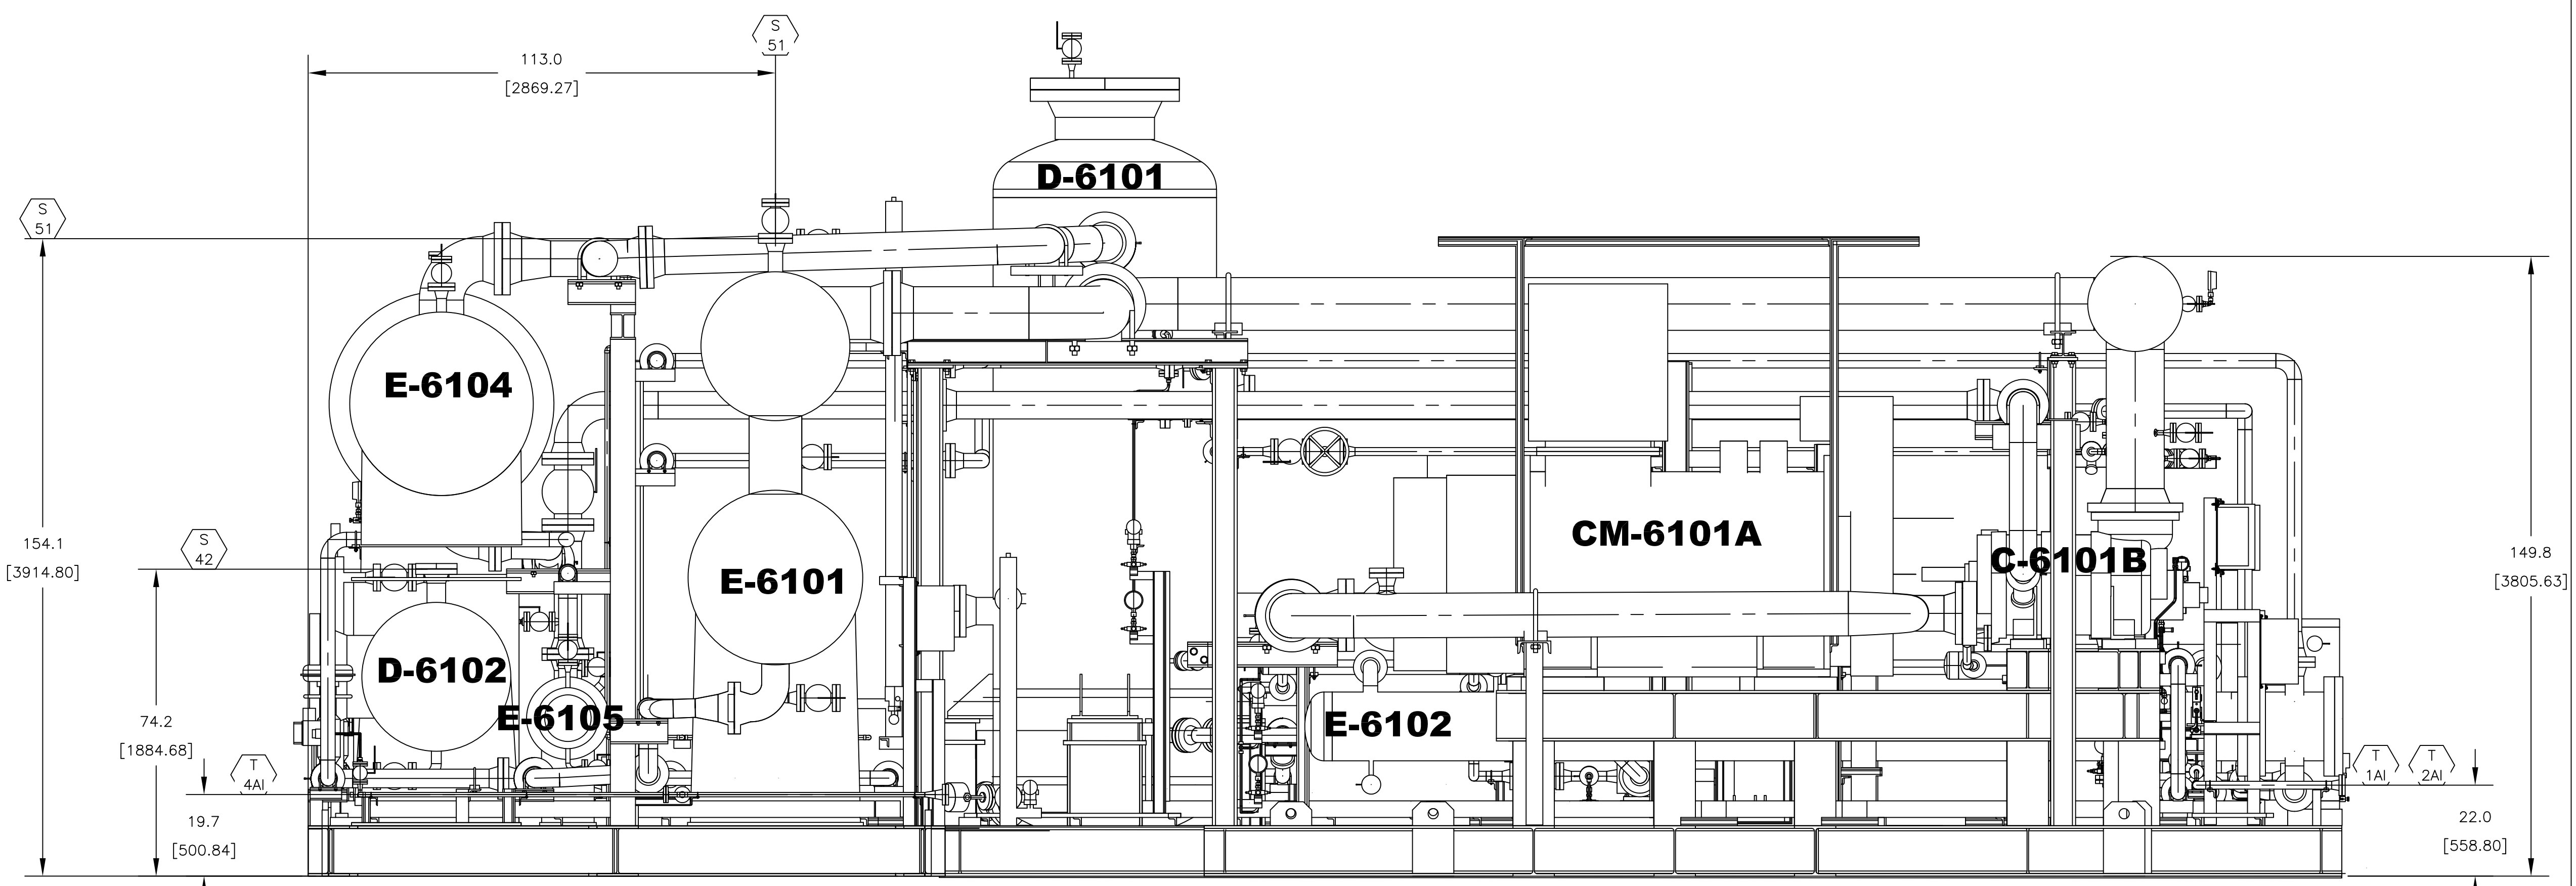

DRAWING NO.	REV.	SHEET NO.	SIZE
VD-GPIC-MA-3029-3029-0062	05	5 OF 12	A1





BACK VIEW

Code1	<input type="checkbox"/> No Comment/ Approved (Applicable Only for "FOR REVIEW" and "For Approval" Documents) No comment and the document are released for Manufacturing.				
Code2	<input type="checkbox"/> No Comment / Approved with Note(s) Vendor/Sub-Contractor shall correct, revise and resubmit the document. The document is released for Manufacturing if changes incorporated.				
Code3	<input type="checkbox"/> Commented Vendor/Sub-Contractor shall correct, revise and resubmit the document by the date specified. The document shall be revised under the Status of "R: Revised Issue". All corrected documents shall be resubmitted before starting the Manufacturing Process.				
Code4	<input type="checkbox"/> Not Accepted (Rejected) Vendor/Sub-Contractor shall re-work/re-design/re-specify the contents of the document according to the comments/reasons for rejection. All corrected documents shall be resubmitted before starting the manufacturing. Vendor/Sub-Contractor shall not proceed with subsequent works of Material Supply or Manufacturing unit receiving Code1/Code2 or No Code from PURCHASER. Vendor/Sub-Contractor shall resubmit the document with the same revision within 6 working days after receiving comments.				
No Code	<input type="checkbox"/> No Code (Only for "For Information" Documents and "As Built DWGs") Document has been submitted for PURCHASER'S information (If) Considering completeness and correctness of document content is in Vendor/Sub-Contractor's responsibility.				
The above checking result by EIED shall in no way relieve Vendor of any liability, obligation and responsibility out of the purchase order and the mutual agreement in writing.					
 DATE : _____ DEPT: _____ Signature : _____					
CV	PI	EL	IN	ME	MA
ST	BU	PR	SA	HV	TL

05	23.02.2026	IFR	FA	IM	OG
04	20.12.2025	IFR	FA	IM	OG
03	05.11.2025	IFR	FA	IM	OG
02	09.10.2025	IFR	FA	IM	OG
01	16.09.2025	IFR	FA	IM	OG
00	28.06.2025	IFR	FA	IM	OG
REV.	DATE (DD.MM.YY)	Purpose of Issue	Prepared	Checked	Approved




Gachasan Plymmer Industries Company
HDPE Plant





PO No.: GPIC-PT-MA-PO-000-3029 SCALE: 1/2":1'

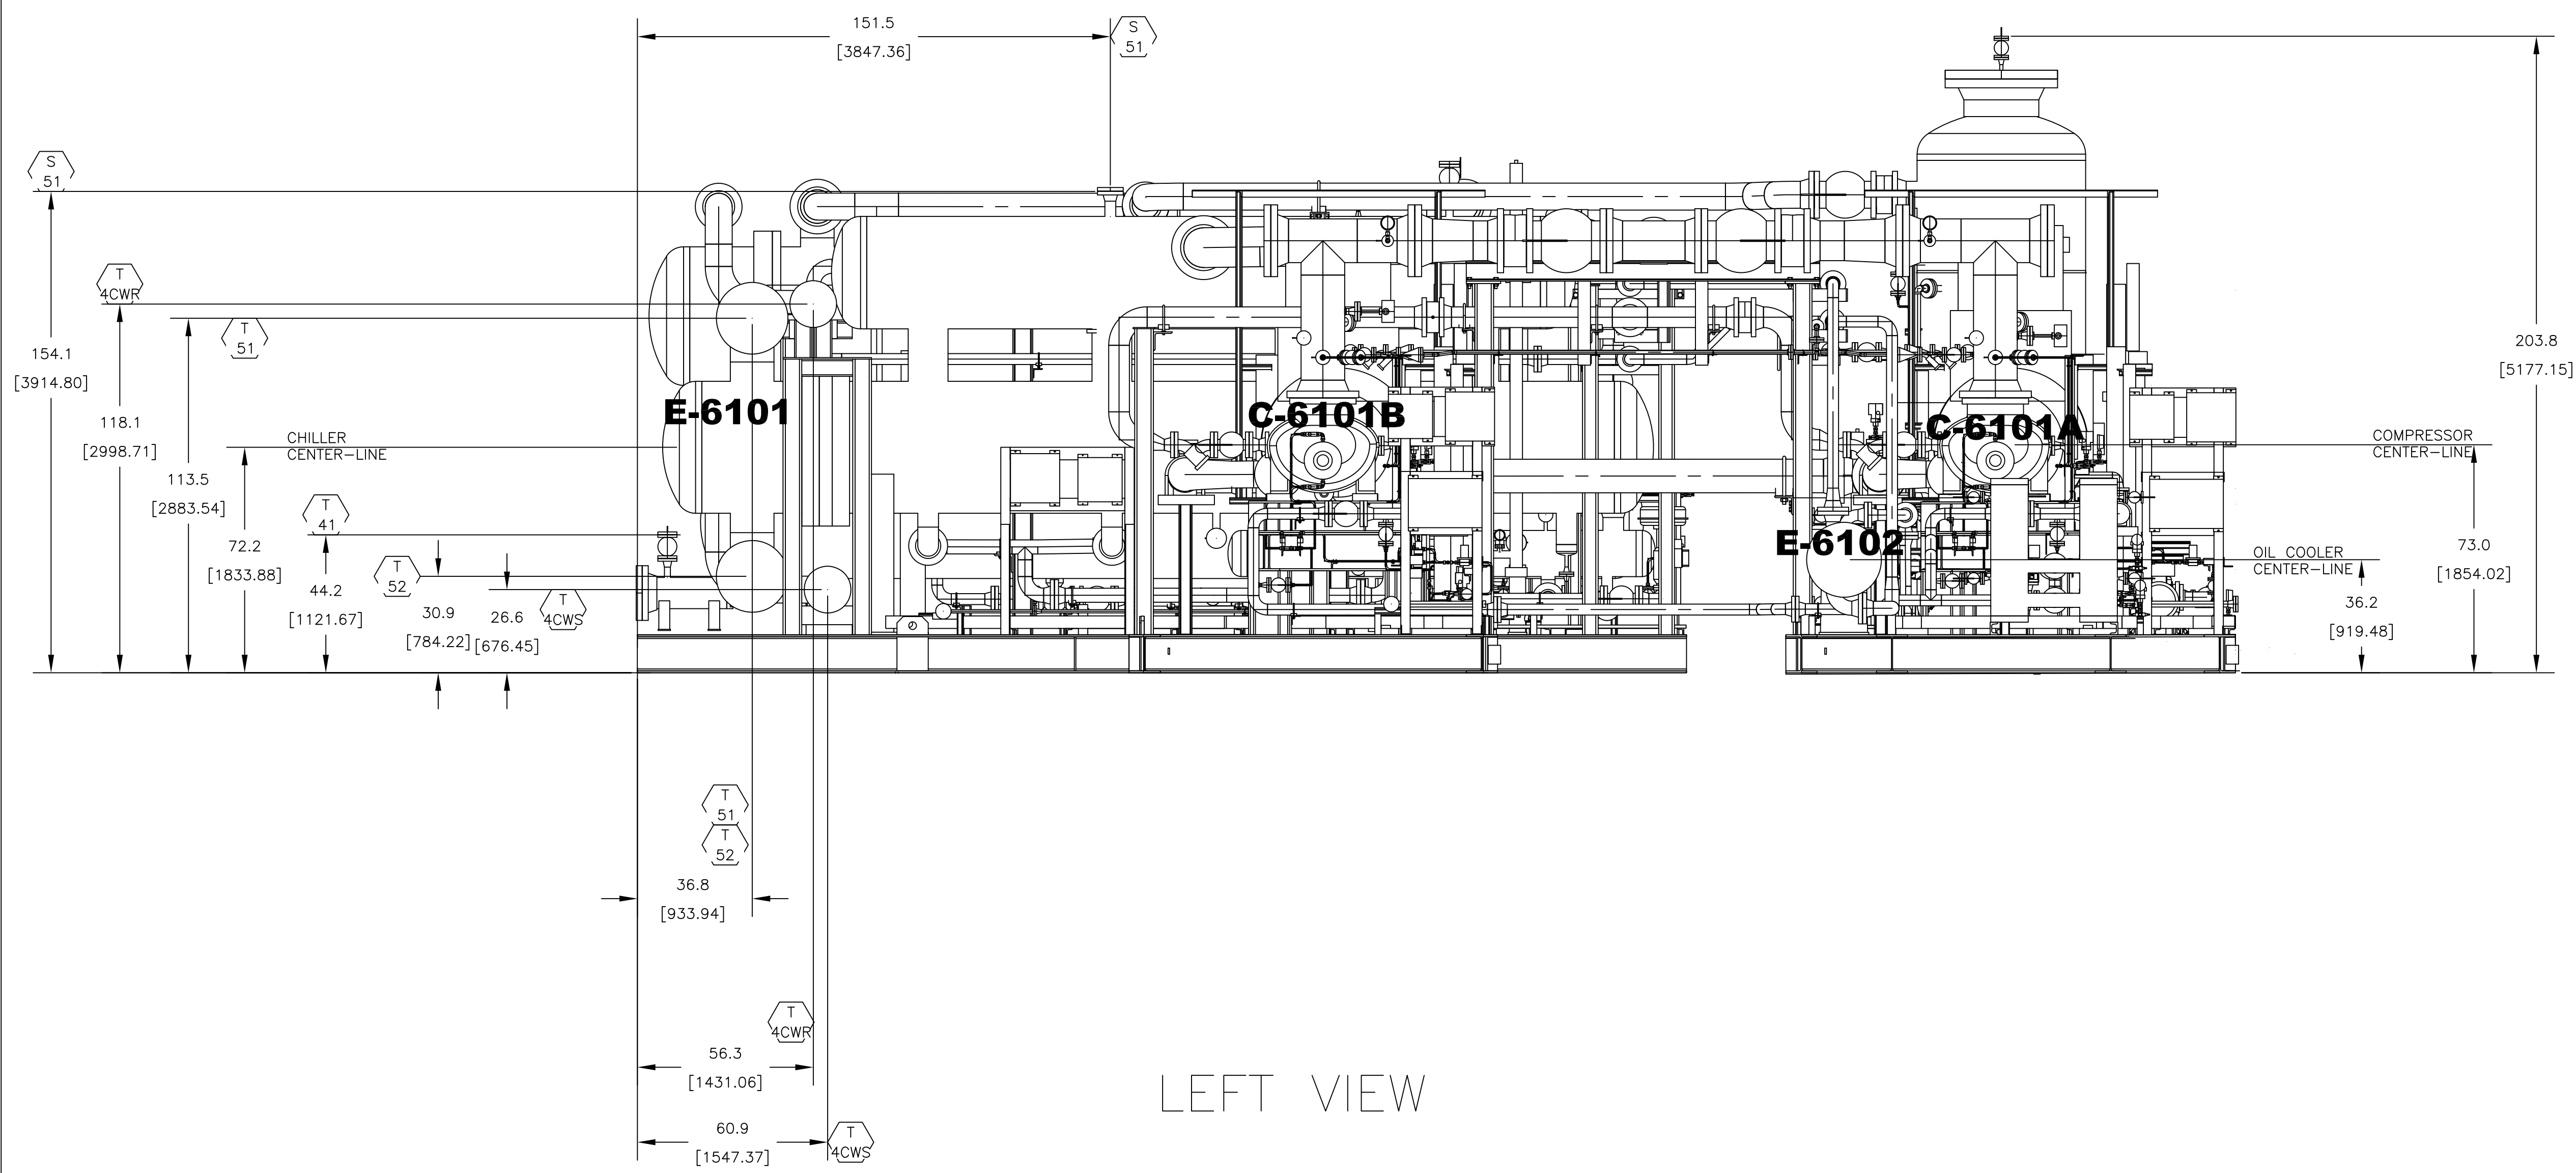

DRAWING TITLE: **GENERAL ARRANGEMENT DRAWING**



DRAWING NO.	VD-GPIC-MA-3029-3029-0062	REV.	SHEET NO.	SIZE
		05	6 OF 12	A1



Code1	<input type="checkbox"/> No Comment/ Approved (Applicable Only for "FOR REVIEW" and "For Approval" Documents) No comment and the document are released for Manufacturing				
Code2	<input type="checkbox"/> No Comment / Approved with Note(s) Vendor/Sub-Contractor shall correct, revise and resubmit the document. The document is released for Manufacturing if changes incorporated.				
Code3	<input type="checkbox"/> Commented Vendor/Sub-Contractor shall correct, revise and resubmit the document by the date specified. The document shall be revised under the Status of "R: Revised Issue". All corrected documents shall be resubmitted before starting the Manufacturing Process				
Code4	<input type="checkbox"/> Not Accepted (Rejected) Vendor/Sub-Contractor shall re-work/re-design/re-specify the contents of the document according to the comments/reasons for rejection. All corrected documents shall be resubmitted before starting the manufacturing. Vendor/Sub-Contractor shall not proceed with subsequent works of Material Supply or Manufacturing unit receiving Code1/Code2 or No Code from PURCHASER. Vendor/Sub-Contractor shall resubmit the document with the same revision within 6 working days after receiving comments				
No Code	<input type="checkbox"/> No Code (Only for "For Information" Documents and "As Built DWG") Document has been submitted for PURCHASER's information (If) Considering completeness and correctness of document content is in Vendor/Sub-Contractor's responsibility.				
The above checking result by EIED shall in no way relieve Vendor of any liability, obligation and responsibility out of the purchase order and the mutual agreement in writing					
 DATE : _____ DEPT: _____ Signature : _____					
CV	PI	EL	IN	ME	MA
ST	BU	PR	SA	HY	TL

REV.	DATE (DD.MM.YY)	Purpose of Issue	Prepared	Checked	Approved
05	23.02.2026	IFR	FA	IM	OG
04	20.12.2025	IFR	FA	IM	OG
03	05.11.2025	IFR	FA	IM	OG
02	09.10.2025	IFR	FA	IM	OG
01	16.09.2025	IFR	FA	IM	OG
00	28.06.2025	IFR	FA	IM	OG




Gachasan Plyomer Industries Company
HDPE Plant

PO No.: GPIC-PT-MA-PO-000-3029 SCALE: 3/8":1'

DRAWING TITLE: **GENERAL ARRANGEMENT DRAWING**

DRAWING NO.	VD-GPIC-MA-3029-3029-0062	REV.	SHEET NO.	SIZE
		05	7 OF 12	A1

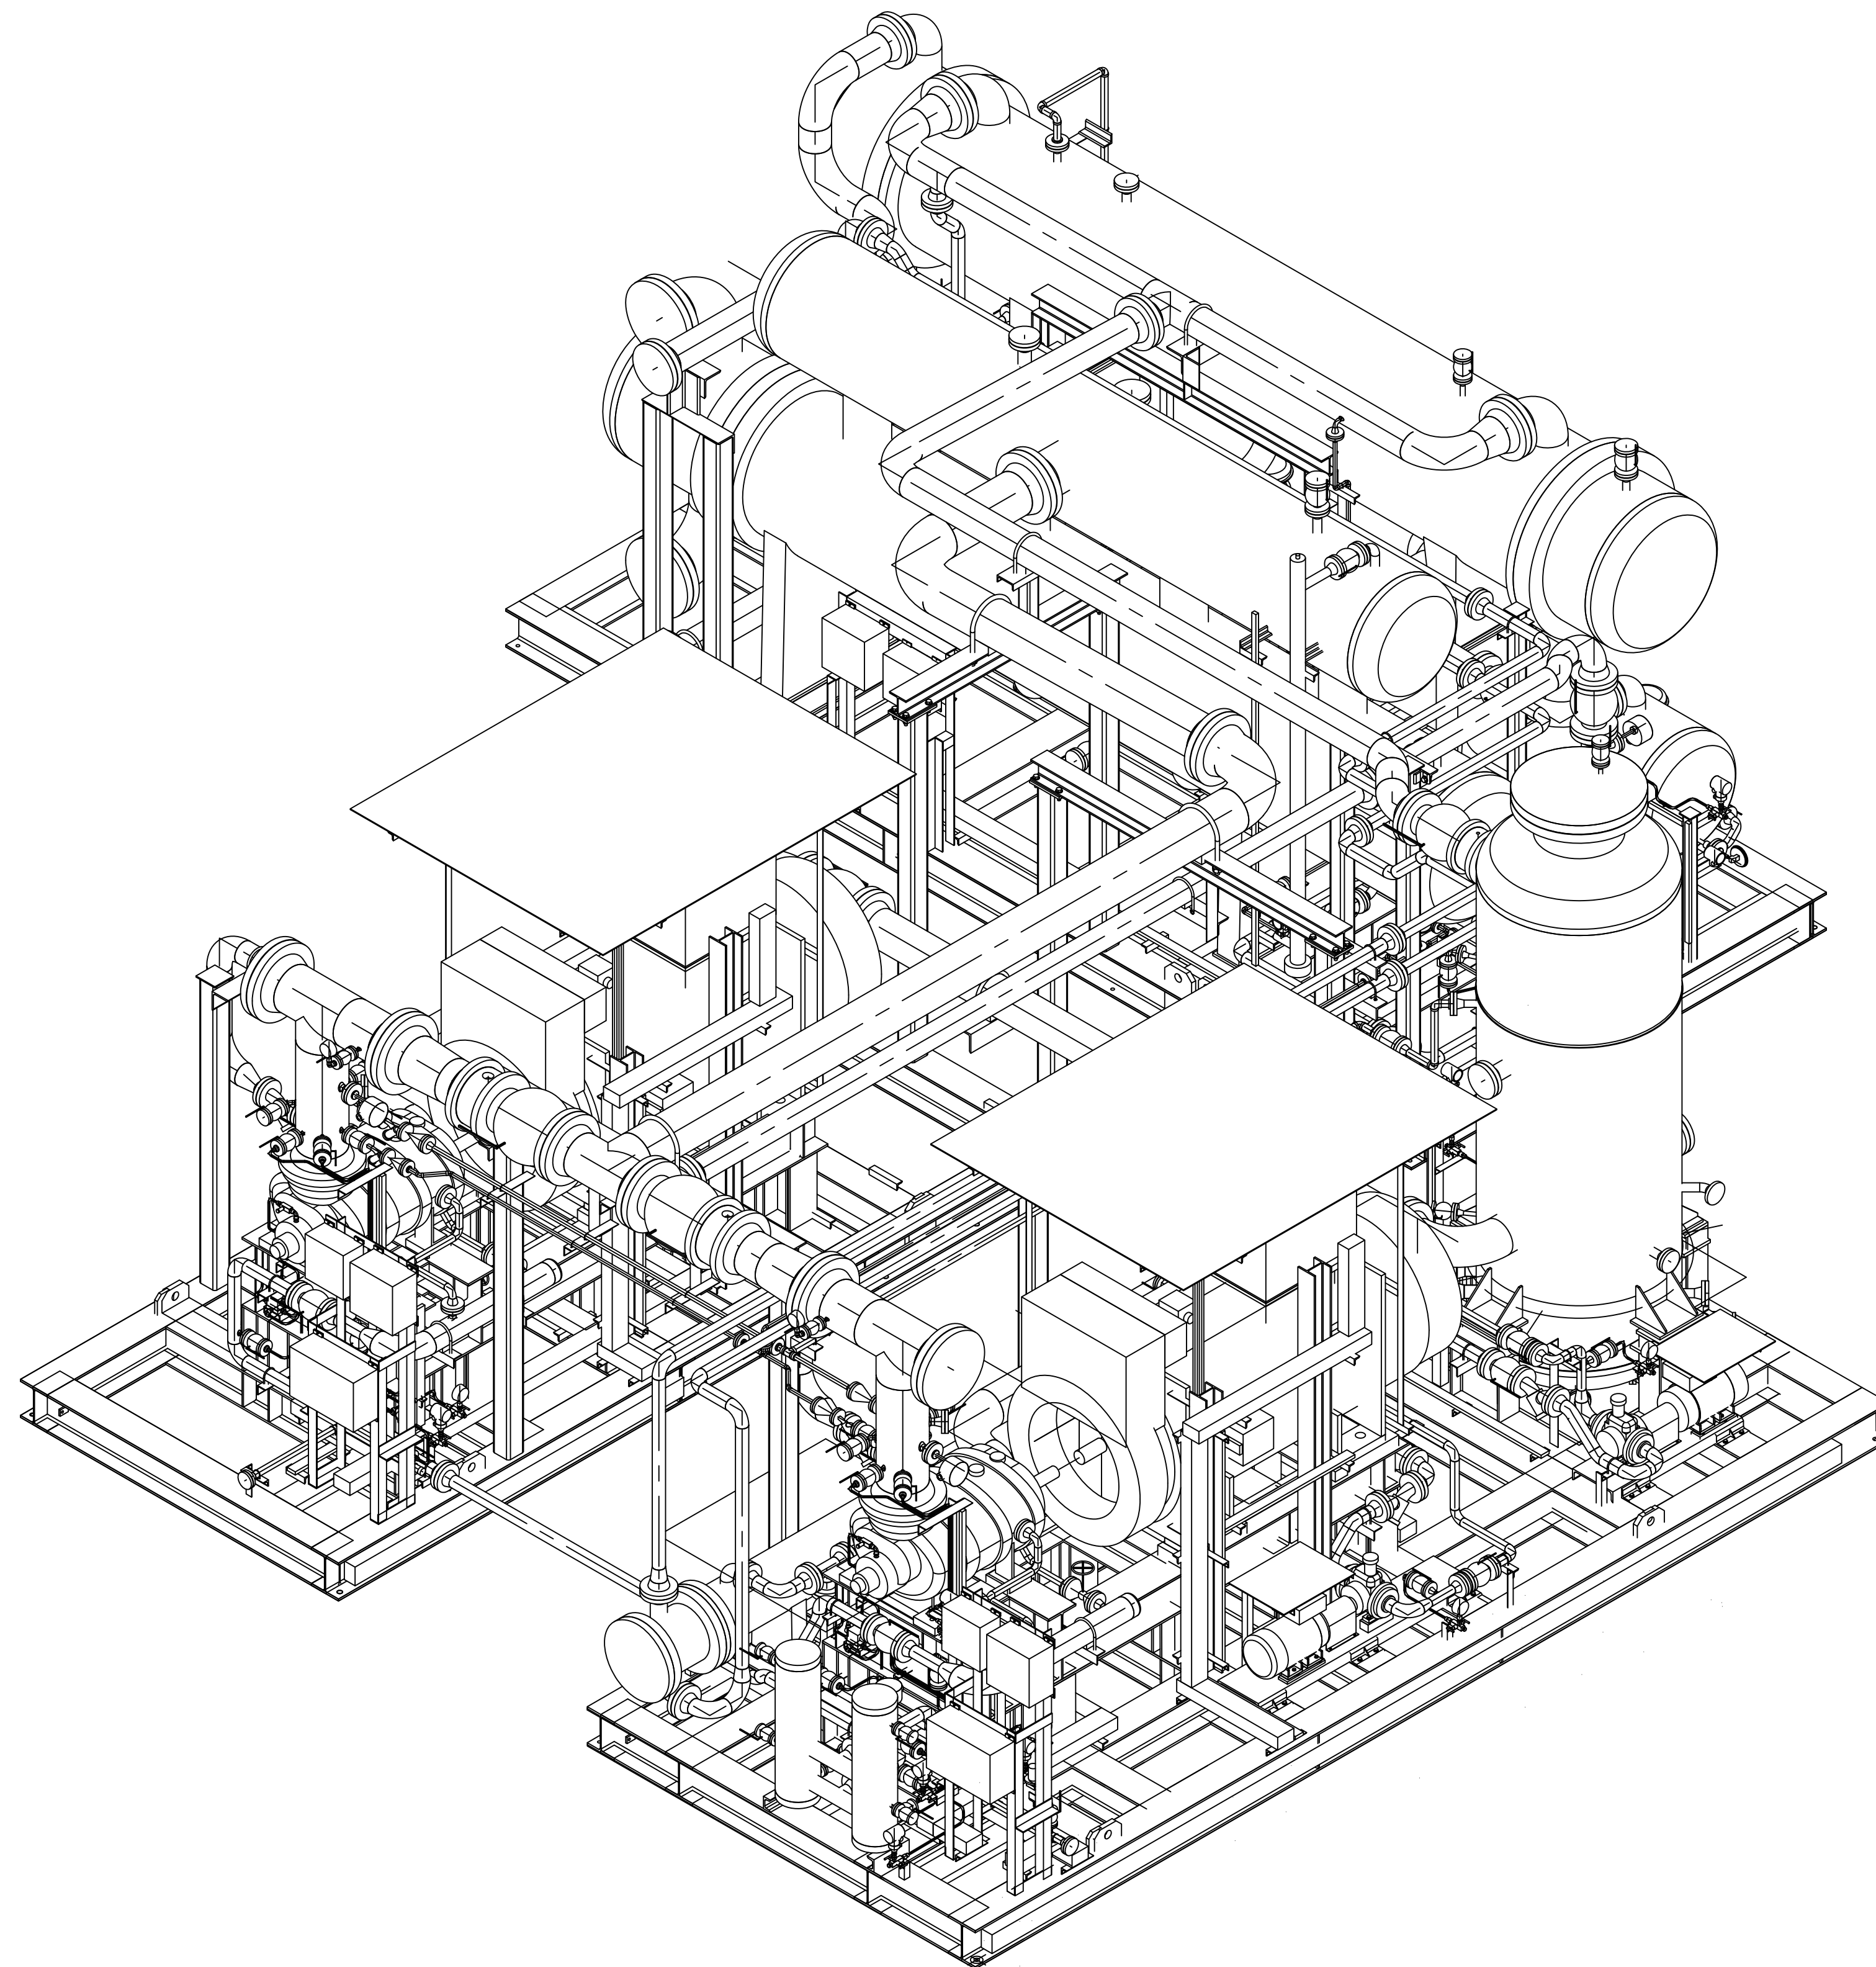


Code1	<input type="checkbox"/> No Comment/ Approved (Applicable Only for "FOR REVIEW" and "For Approval" Documents) No comment and the document are released for Manufacturing				
Code2	<input type="checkbox"/> No Comment / Approved with Note(s) Vendor/Sub-Contractor shall correct, revise and resubmit the document. The document is released for Manufacturing if changes incorporated.				
Code3	<input type="checkbox"/> Commented Vendor/Sub-Contractor shall correct, revise and resubmit the document by the date specified. The document shall be revised under the Status of "R: Revised Issue". All corrected documents shall be resubmitted before starting the Manufacturing Process				
Code4	<input type="checkbox"/> Not Accepted (Rejected) Vendor/Sub-Contractor shall re-work/re-design/re-specify the contents of the document according to the comments/reasons for rejection. All corrected documents shall be resubmitted before starting the manufacturing. Vendor/Sub-Contractor shall not proceed with subsequent works of Material Supply or Manufacturing until receiving Code1/Code2 or No Code from PURCHASER. Vendor/Sub-Contractor shall resubmit the document with the same revision within 6 working days after receiving comments				
No Code	<input type="checkbox"/> No Code (Only for "For Information" Documents and "As Built DWGs") Document has been submitted for PURCHASER'S information (If) Consistency, completeness and correctness of document content is in Vendor/Sub-Contractor's responsibility.				
The above checking result by EIED shall in no way relieve Vendor of any liability, obligation and responsibility out of the purchase order and the mutual agreement in writing					
DATE : DEPT : Signature :					
CV	PI	EL	IN	ME	MA
ST	BU	PR	SA	HV	TL

05	23.02.2026	IFR	FA	IM	OG
04	20.12.2025	IFR	FA	IM	OG
03	05.11.2025	IFR	FA	IM	OG
02	09.10.2025	IFR	FA	IM	OG
01	16.09.2025	IFR	FA	IM	OG
00	28.06.2025	IFR	FA	IM	OG
REV.	DATE (DD.MM.YY)	Purpose of Issue	Prepared	Checked	Approved

		Gacharan Plyomer Industries Company	
		HDPE Plant	
PO No.: GPIC-PT-MA-PO-000-3029			SCALE: 3/8":1'

DRAWING TITLE:
GENERAL ARRANGEMENT DRAWING

DRAWING NO.	VD-GPIC-MA-3029-3029-0062	REV.	SHEET NO.	SIZE
		05	8 OF 12	A1

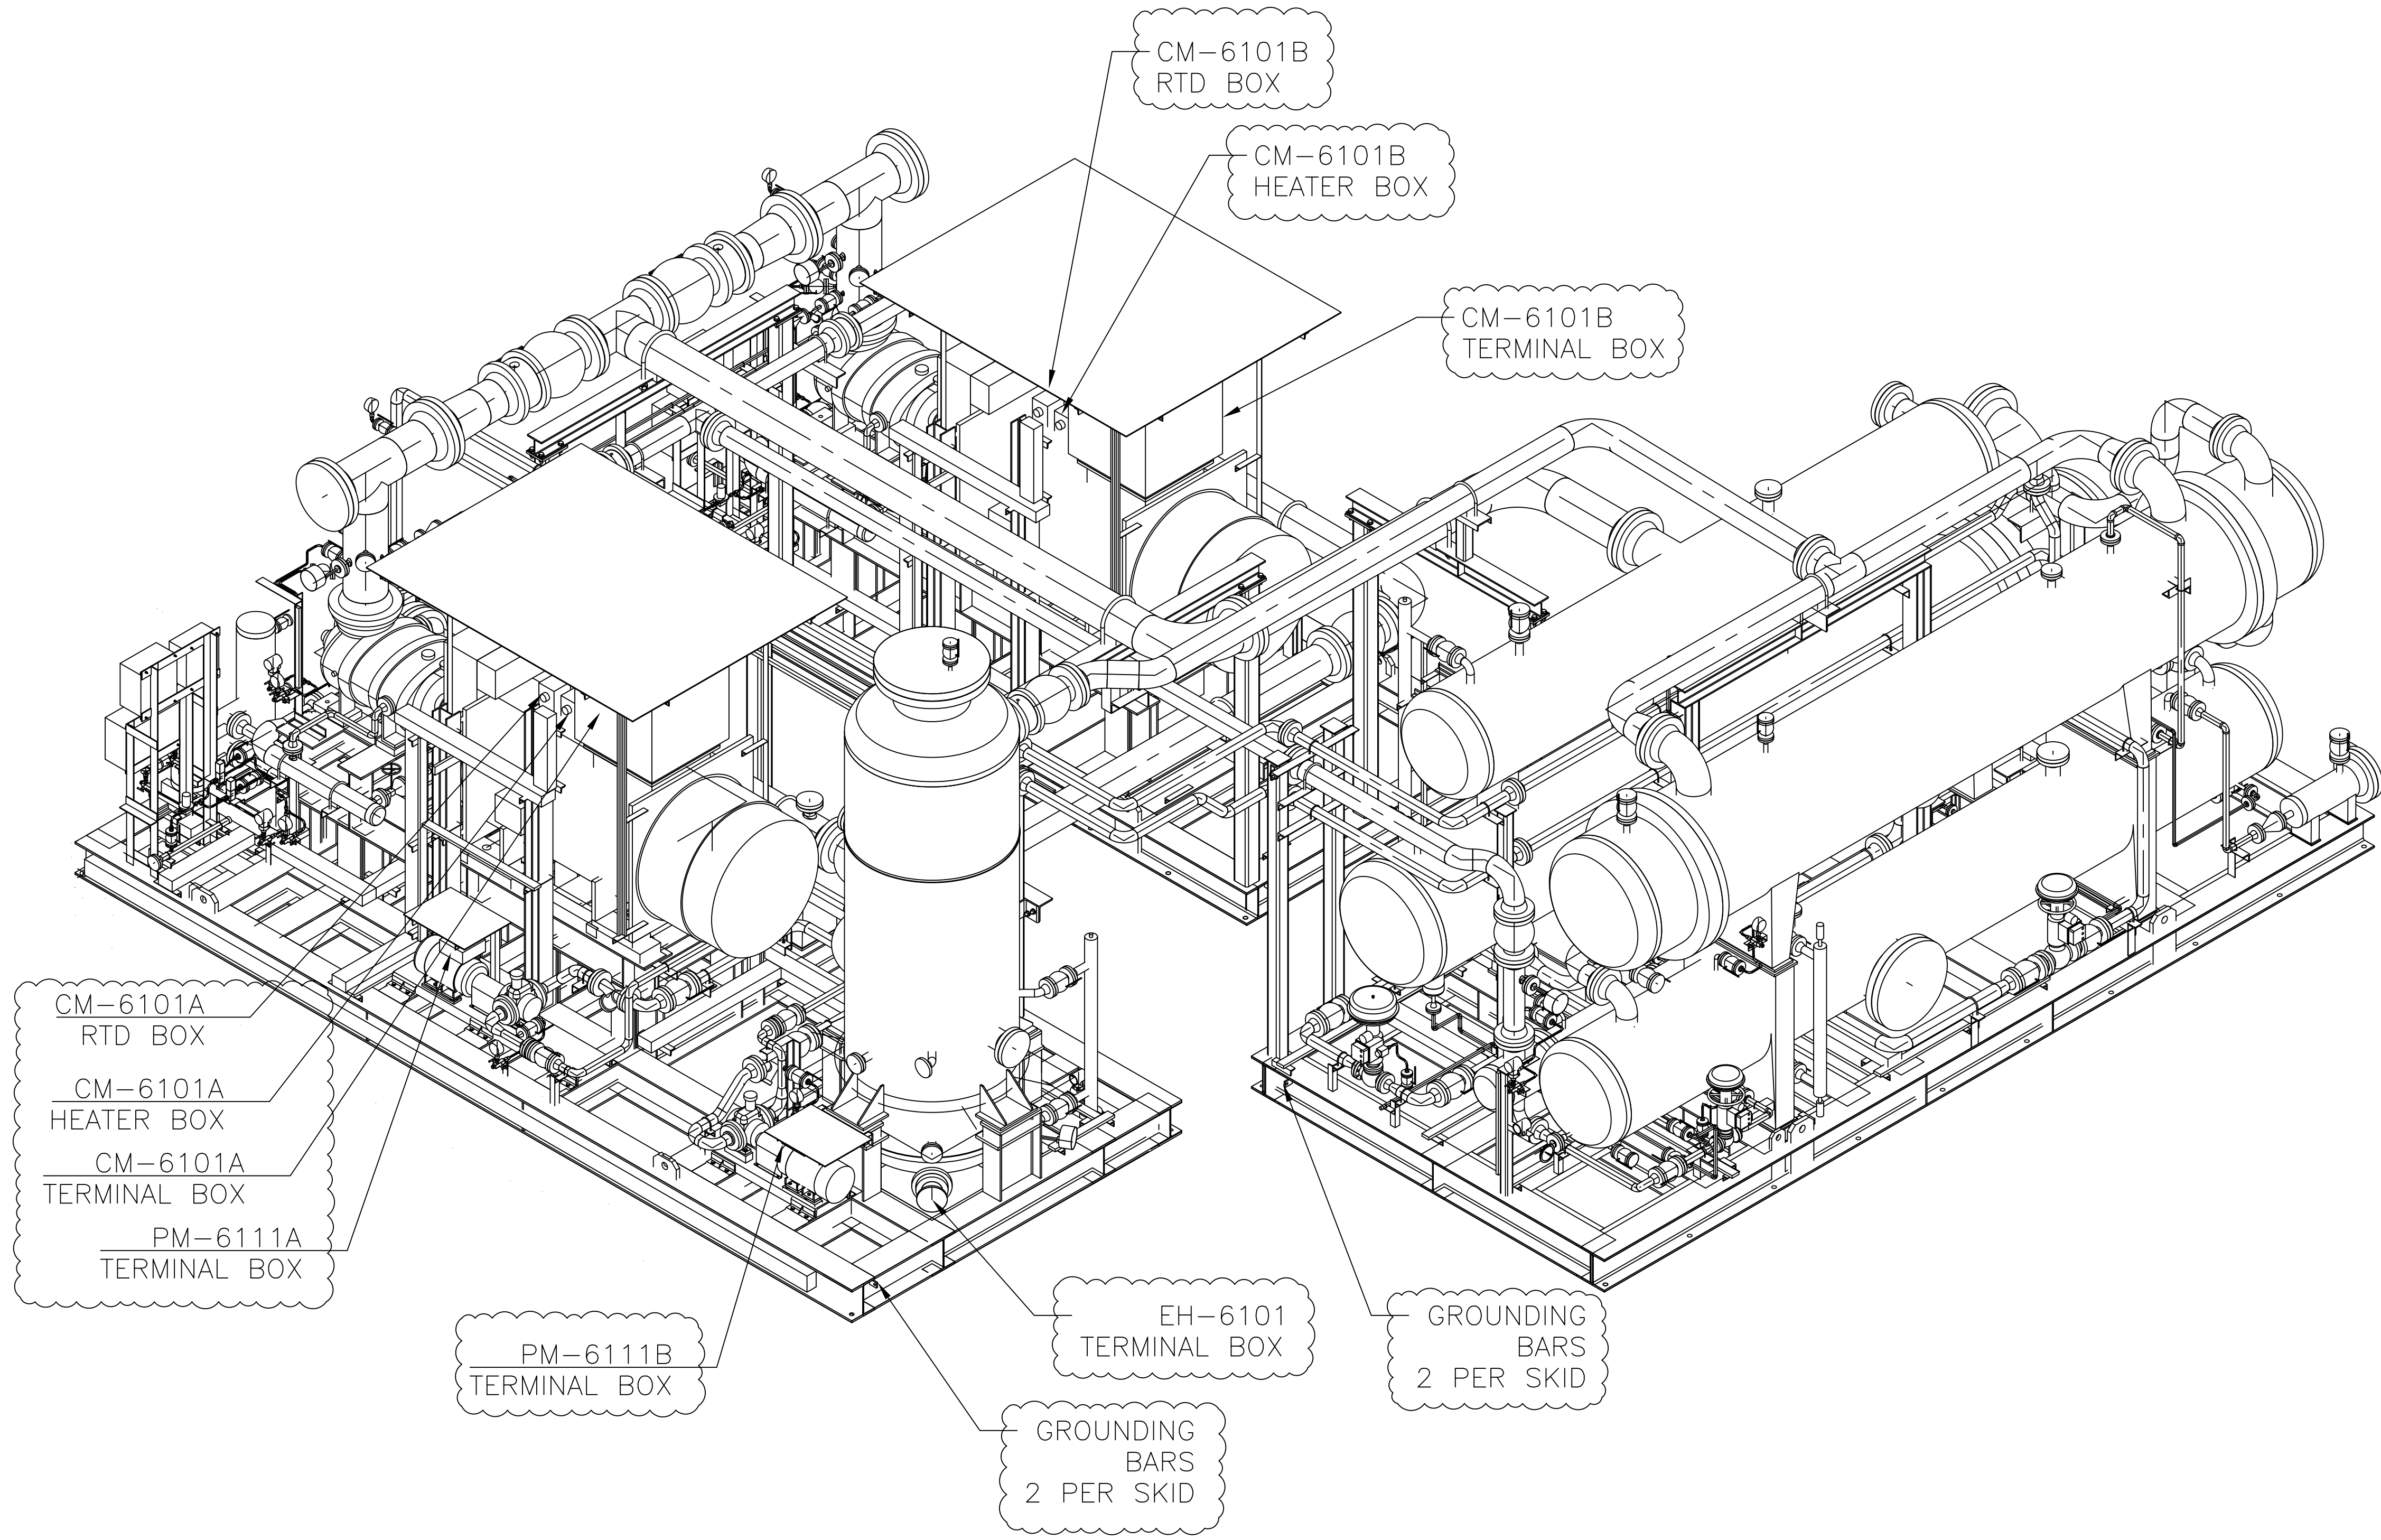

Code1	<input type="checkbox"/> No Comment/ Approved (Applicable Only for "FOR REVIEW" and "For Approval" Documents) No comment and the document are released for Manufacturing
Code2	<input type="checkbox"/> No Comment / Approved with Note(s) Vendor/Sub-Contractor shall correct, revise and resubmit the document. The document is released for Manufacturing if changes incorporated.
Code3	<input type="checkbox"/> Commented Vendor/Sub-Contractor shall correct, revise and resubmit the document by the date specified. The document shall be revised under the Status of "R: Revised Issue". All corrected documents shall be resubmitted before starting the Manufacturing Process
Code4	<input type="checkbox"/> Not Accepted (Rejected) Vendor/Sub-Contractor shall re-work/re-design/re-specify the contents of the document according to the comments/reasons for rejection. All corrected documents shall be resubmitted before starting the manufacturing. Vendor/Sub-Contractor shall not proceed with subsequent works of Material Supply or Manufacturing unit receiving Code1/Code2 or No Code from PURCHASER. Vendor/Sub-Contractor shall resubmit the document with the same revision within 6 working days after receiving comments
No Code	<input type="checkbox"/> No Code (Only for "For Information" Documents and "As Built DWG") Document has been submitted for PURCHASER'S Information (I). Considering completeness and correctness of document content is in Vendor/Sub-Contractor's responsibility.


The above checking result by EIED shall in no way relieve Vendor of any liability, obligation and responsibility out of the purchase order and the mutual agreement in writing.

DATE :
DEPT :
Signature :

CV	PI	EL	IN	ME	MA
ST	BU	PR	SA	HY	TL

05	23.02.2026	IFR	FA	IM	OG
04	20.12.2025	IFR	FA	IM	OG
03	05.11.2025	IFR	FA	IM	OG
02	09.10.2025	IFR	FA	IM	OG
01	16.09.2025	IFR	FA	IM	OG
00	28.06.2025	IFR	FA	IM	OG
REV.	DATE (DD.MM.YY)	Purpose of Issue	Prepared	Checked	Approved

		Gachasan Polymer Industries Company HDPE Plant		
PO No.: GPIC-PT-MA-PO-000-3029			SCALE: 3/8":1'	
DRAWING TITLE: GENERAL ARRANGEMENT DRAWING				
DRAWING NO. VD-GPIC-MA-3029-3029-0062	REV. 05	SHEET NO. 9 OF 12	SIZE A1	

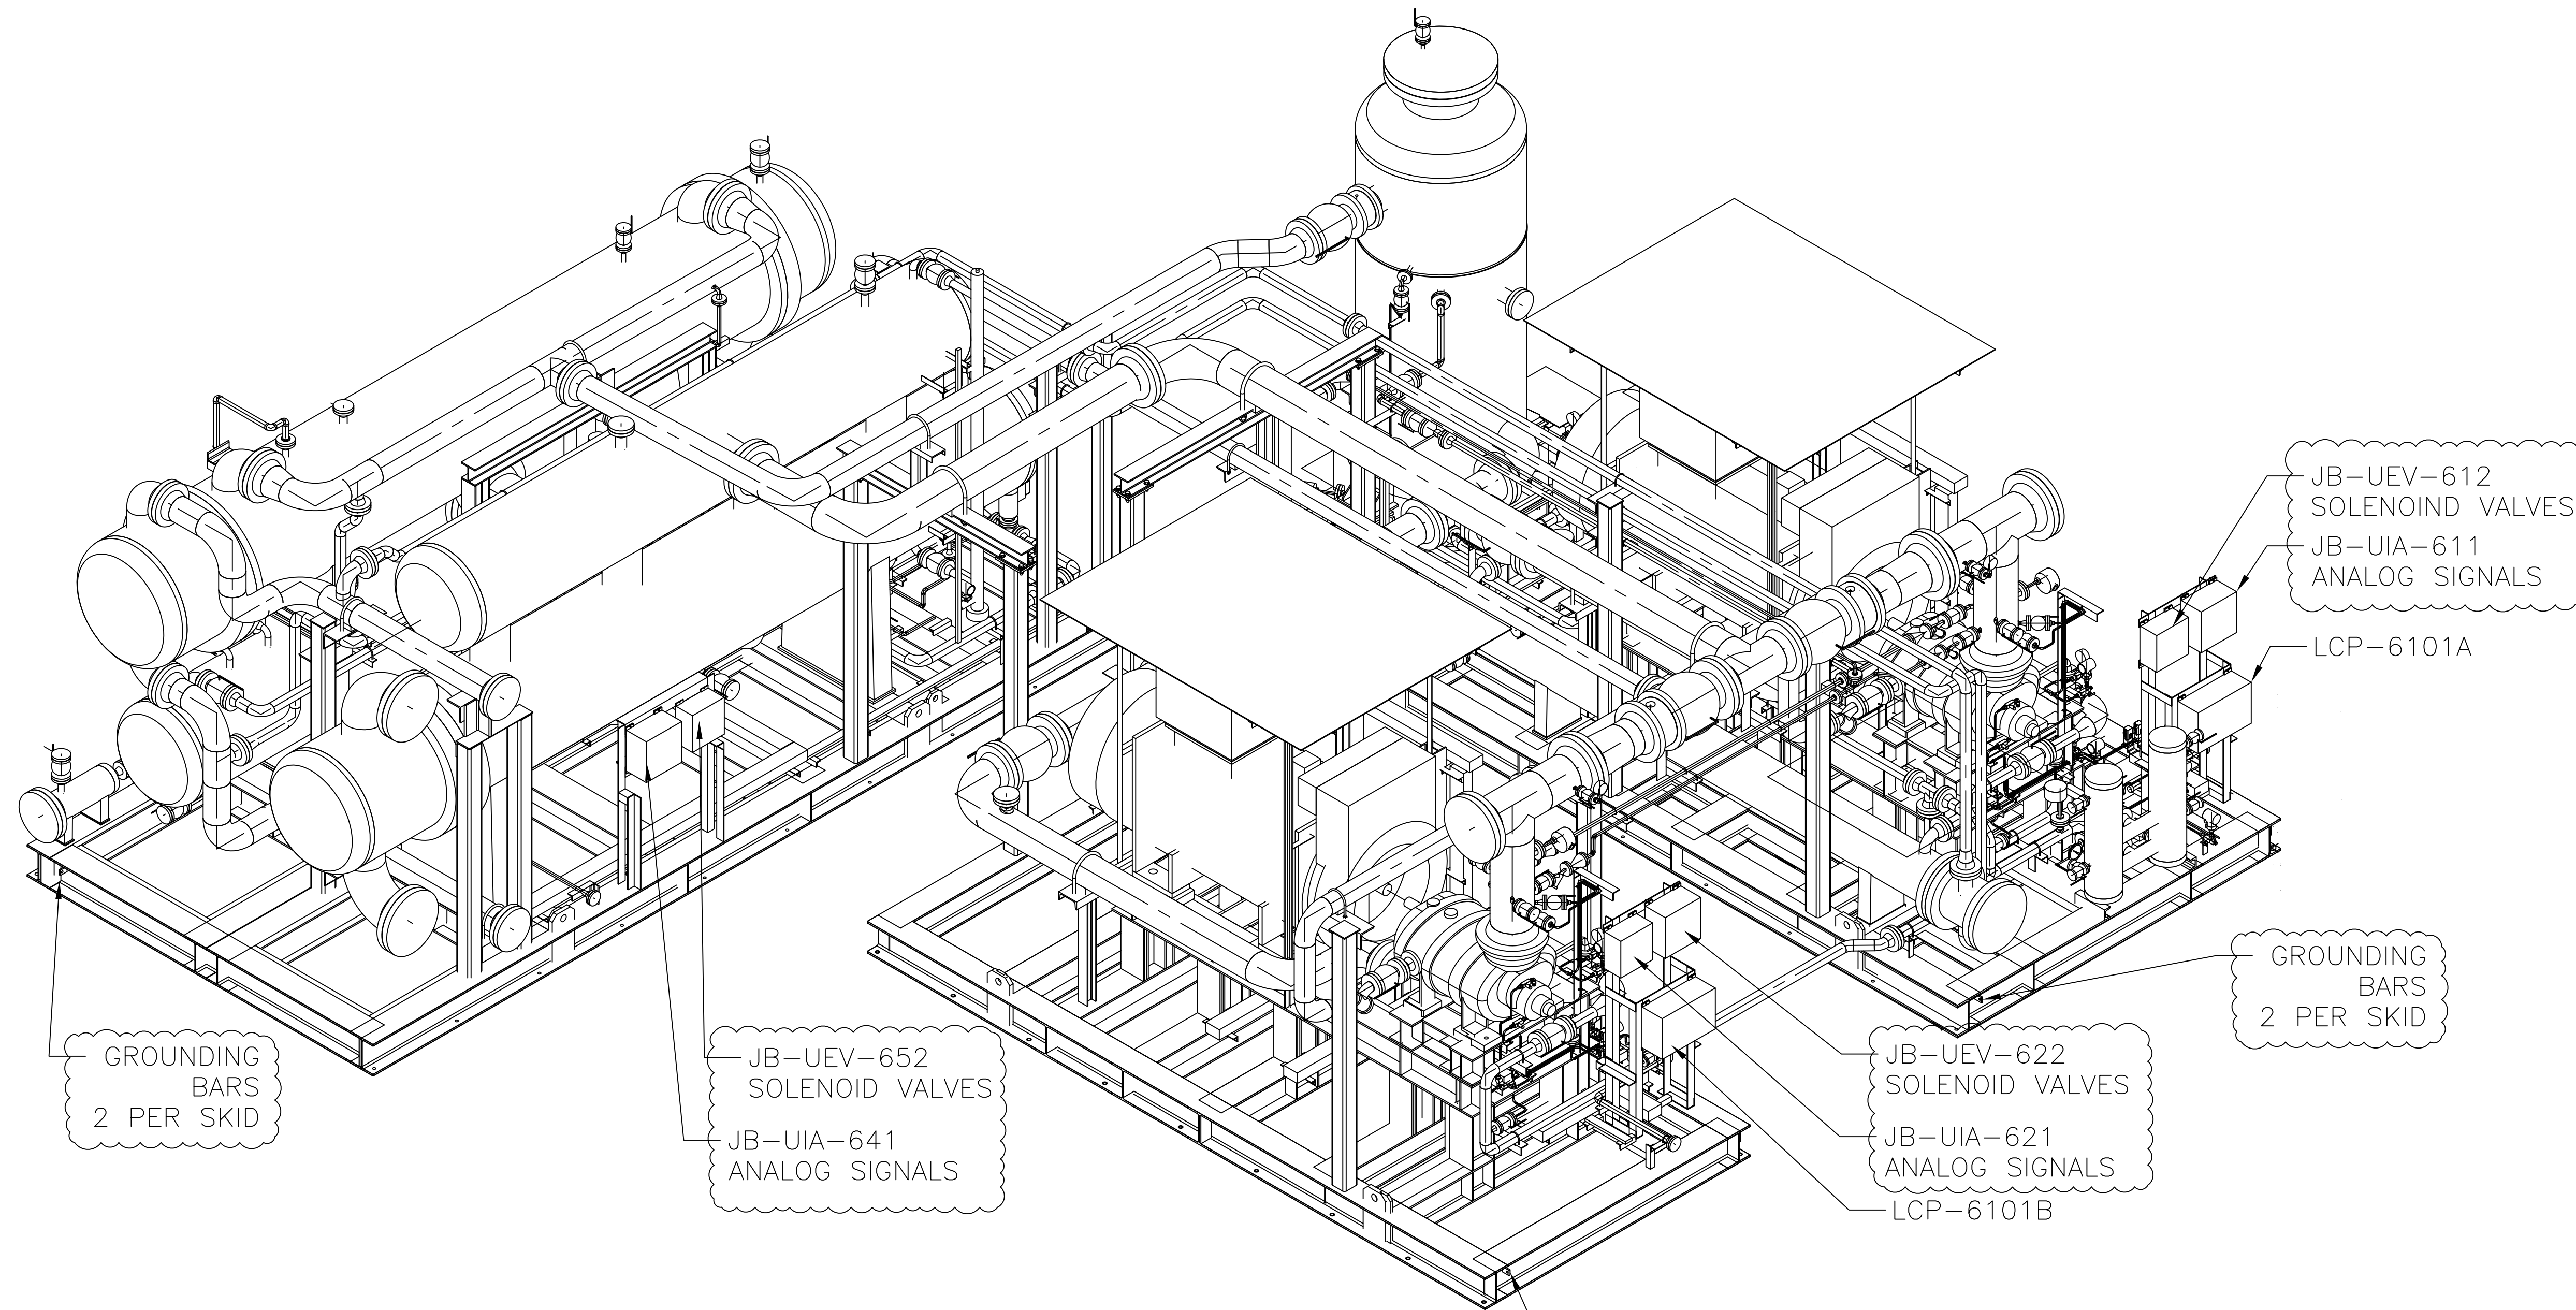

GROUNDING BARS
2 PER SKID

JB-UEV-652
SOLENOID VALVES
JB-UIA-641
ANALOG SIGNALS

JB-UEV-612
SOLENOID VALVES
JB-UIA-611
ANALOG SIGNALS

LCP-6101A

GROUNDING BARS
2 PER SKID


JB-UEV-622
SOLENOID VALVES
JB-UIA-621
ANALOG SIGNALS
LCP-6101B

GROUNDING BARS
2 PER SKID

Code1	<input type="checkbox"/> No Comment/ Approved (Applicable Only for "FOR REVIEW" and "For Approval" Documents) No comment and the document are released for Manufacturing				
Code2	<input type="checkbox"/> No Comment / Approved with Note(s) Vendor/Sub-Contractor shall correct, revise and resubmit the document. The document is released for Manufacturing if changes incorporated.				
Code3	<input type="checkbox"/> Commented Vendor/Sub-Contractor shall correct, revise and resubmit the document by the date specified. The document shall be revised under the Status of "R: Revised Issue". All corrected documents shall be resubmitted before starting the Manufacturing Process				
Code4	<input type="checkbox"/> Not Accepted (Rejected) Vendor/Sub-Contractor shall re-work/re-design/re-specify the contents of the document according to the comments/reasons for rejection. All corrected documents shall be resubmitted before starting the manufacturing. Vendor/Sub-Contractor shall not proceed with subsequent works of Material Supply or Manufacturing until receiving Code1/Code2 or No Code from PURCHASER. Vendor/Sub-Contractor shall resubmit the document with the same revision within 6 working days after receiving comments				
No Code	<input type="checkbox"/> No Code (Only for "For Information" Documents and "As Built DWG") Document has been submitted for PURCHASER'S Information (FI). Considering completeness and correctness of document content is in Vendor/Sub-Contractor's responsibility.				
The above checking result by EED shall in no way relieve Vendor of any liability, obligation and responsibility out of the purchase order and the mutual agreement in writing.					
DATE : _____					
DEPT: _____					
Signature : _____					
CV	PI	EL	IN	ME	MA
ST	BU	PR	SA	HY	TL

05	23.02.2026	IFR	FA	IM	OG
04	20.12.2025	IFR	FA	IM	OG
03	05.11.2025	IFR	FA	IM	OG
02	09.10.2025	IFR	FA	IM	OG
01	16.09.2025	IFR	FA	IM	OG
00	28.06.2025	IFR	FA	IM	OG
REV.	DATE (DD.MM.YY)	Purpose of Issue	Prepared	Checked	Approved

		Gacharan Plyomer Industries Company HDPE Plant		
PO No.: GPIC-PT-MA-PO-000-3029		SCALE: 3/8":1'		
DRAWING TITLE: GENERAL ARRANGEMENT DRAWING				
DRAWING NO. VD-GPIC-MA-3029-3029-0062	REV. 05	SHEET NO. 10 OF 12	SIZE A1	

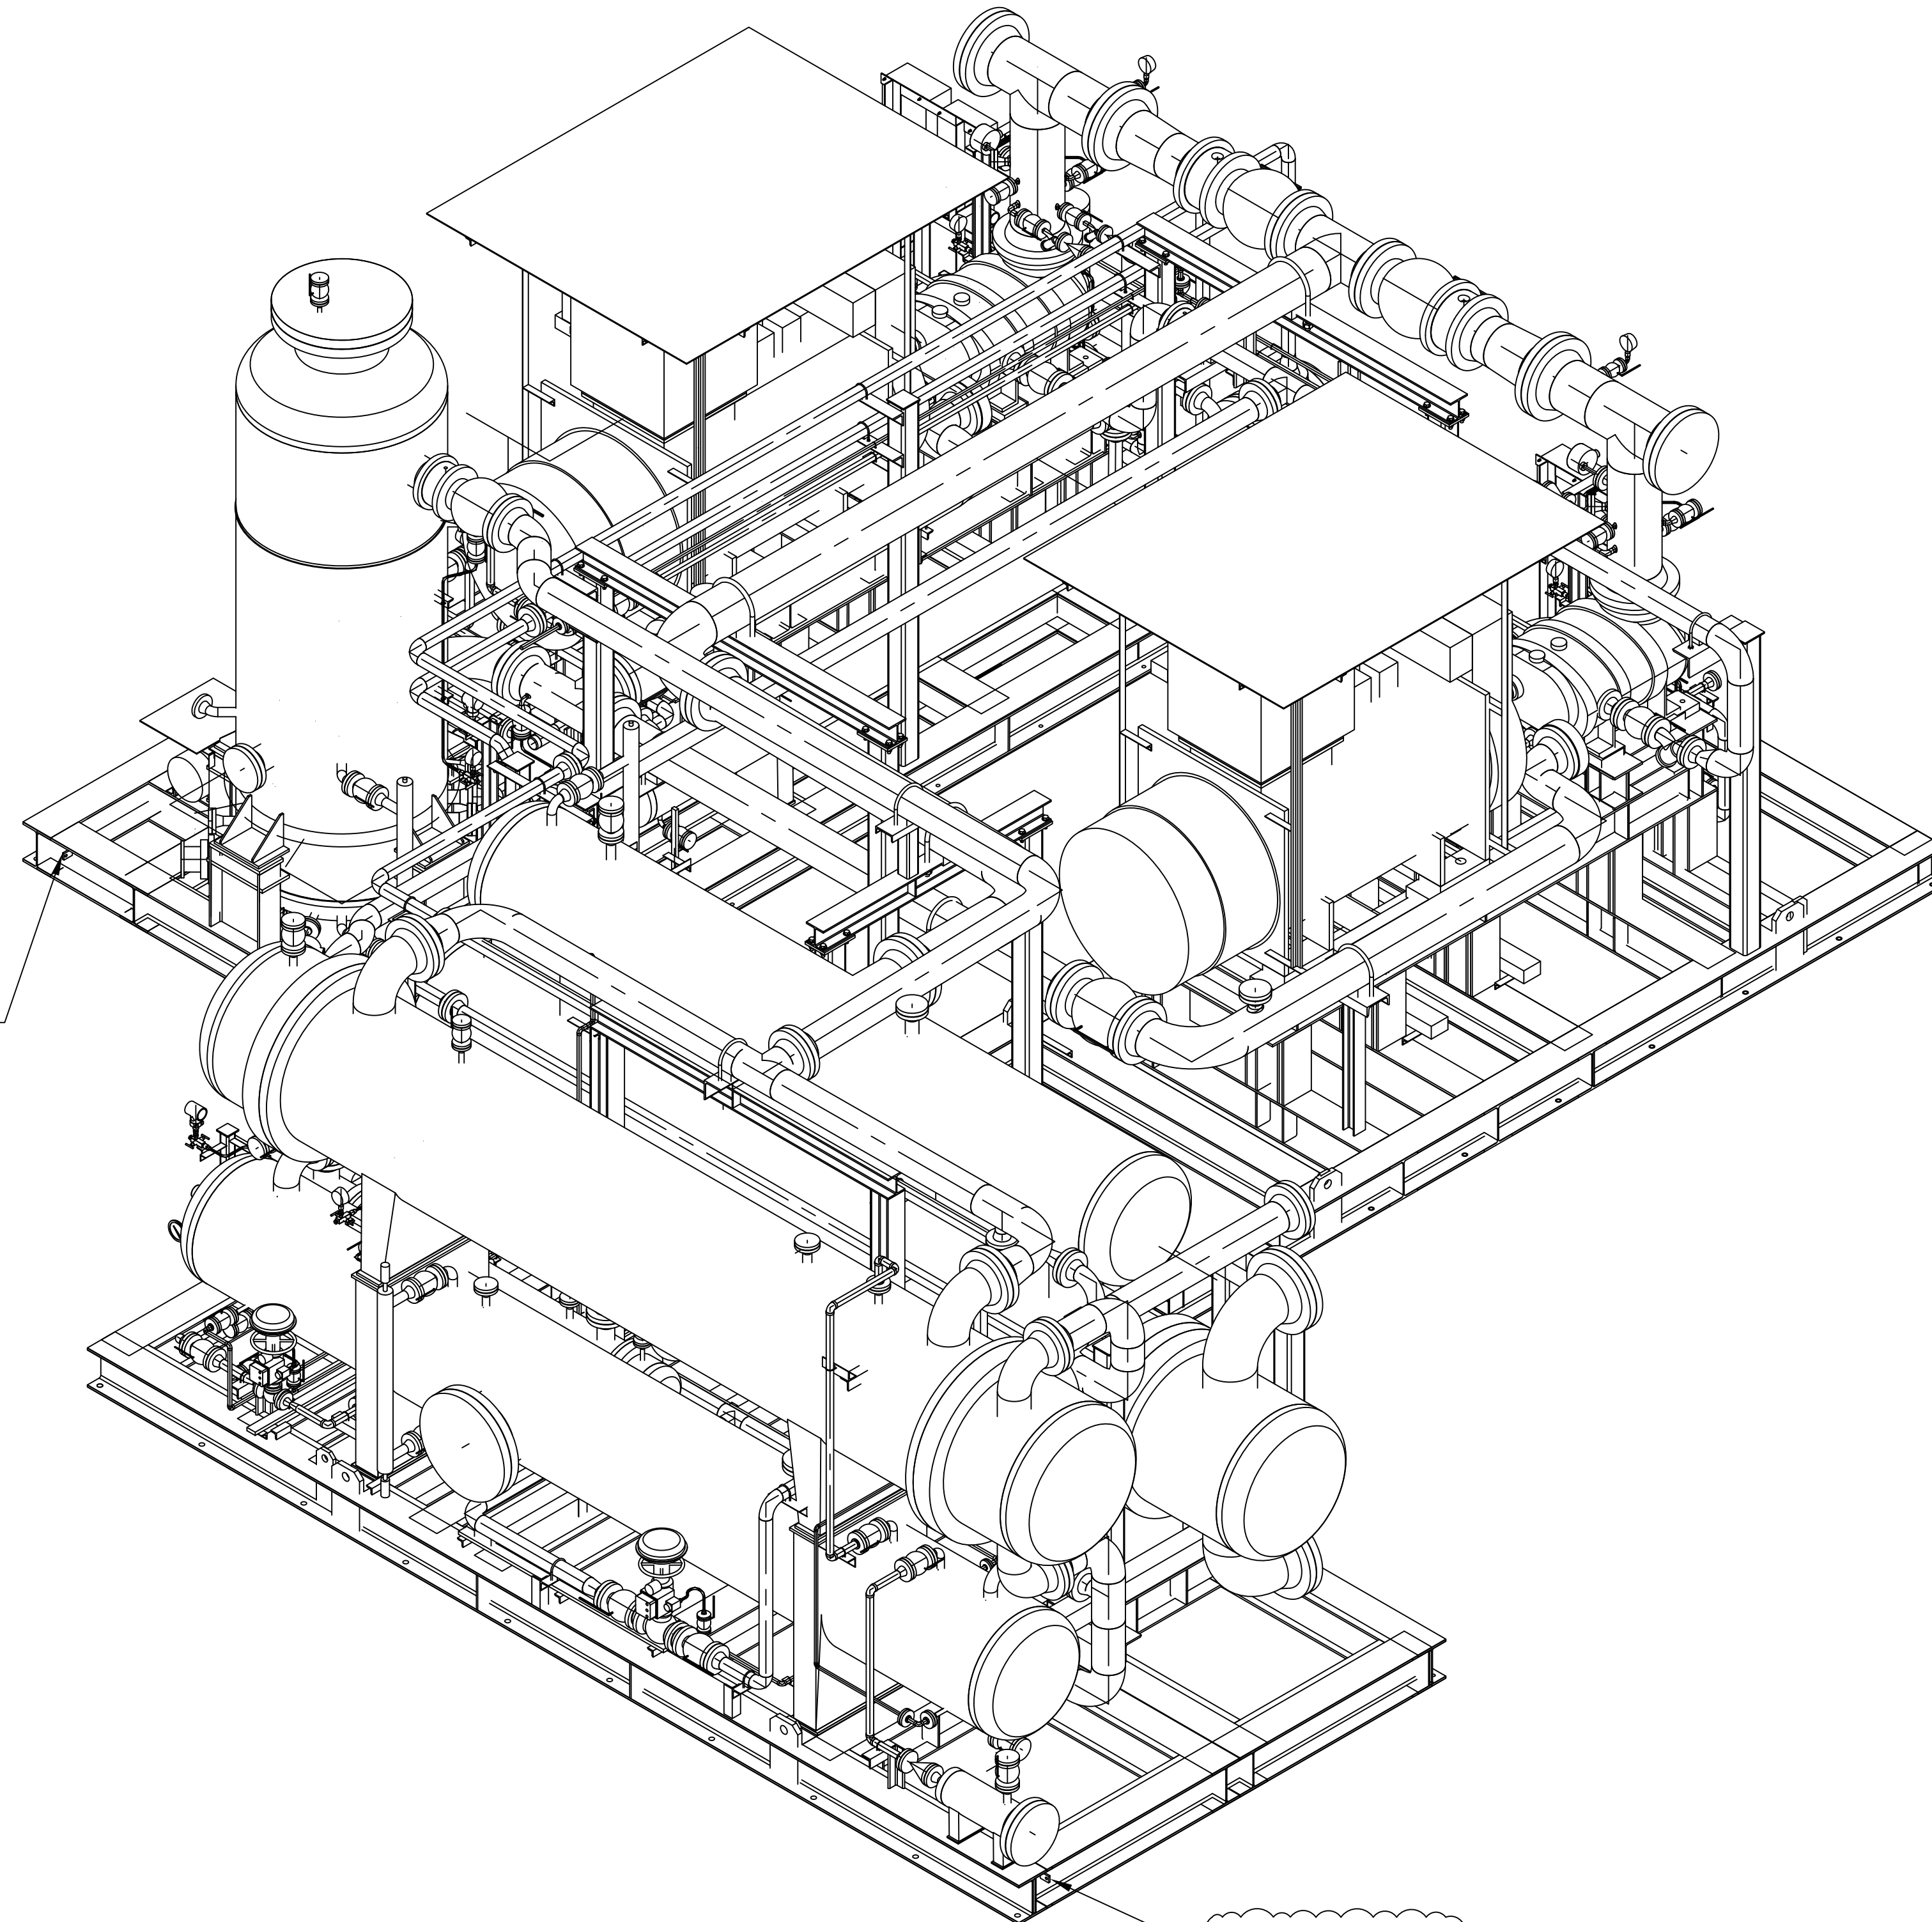





GROUNDING
BARS
2 PER SKID

GROUNDING
BARS
2 PER SKID

Code1	<input type="checkbox"/> No Comment/ Approved (Applicable Only for "FOR REVIEW" and "For Approval" Documents) No comment and the document are released for Manufacturing				
Code2	<input type="checkbox"/> No Comment / Approved with Note(s) Vendor/Sub-Contractor shall correct, revise and resubmit the document. The document is released for Manufacturing if changes incorporated.				
Code3	<input type="checkbox"/> Commented Vendor/Sub-Contractor shall correct, revise and resubmit the document by the date specified. The document shall be revised under the Status of "R: Revised Issue". All corrected documents shall be resubmitted before starting the Manufacturing Process				
Code4	<input type="checkbox"/> Not Accepted (Rejected) Vendor/Sub-Contractor shall re-work/re-design/re-specify the contents of the document according to the comments/reasons for rejection. All corrected documents shall be resubmitted before starting the manufacturing. Vendor/Sub-Contractor shall not proceed with subsequent works of Material Supply or Manufacturing unit receiving Code1/Code2 or No Code from PURCHASER. Vendor/Sub-Contractor shall resubmit the document with the same revision within 6 working days after receiving comments				
No Code	<input type="checkbox"/> No Code (Only for "For Information" Documents and "As Built DWGs") Document has been submitted for PURCHASER's Information (I). Considering completeness and correctness of document content is in Vendor/Sub-Contractor's responsibility. The above checking result by EIED shall in no way relieve Vendor of any liability, obligation and responsibility out of the purchase order and the mutual agreement in writing.				
<p>DATE : _____</p> <p>DEPT: _____</p> <p>Signature : _____</p>					
CV	FI	EL	IN	ME	MA
ST	BU	PR	SA	HV	TL

05	23.02.2026	IFR	FA	IM	OG
04	20.12.2025	IFR	FA	IM	OG
03	05.11.2025	IFR	FA	IM	OG
02	09.10.2025	IFR	FA	IM	OG
01	16.09.2025	IFR	FA	IM	OG
00	28.06.2025	IFR	FA	IM	OG
REV.	DATE (DD.MM.YY)	Purpose of Issue	Prepared	Checked	Approved

 Gachsaran Polymer Industries Company	 Gachsaran Plyomer Industries Company HDPE Plant	  DELTA PROCESS EQUIPMENT
PO No.: GPIC-PT-MA-PO-000-3029		SCALE: 3/8":1"
DRAWING TITLE: GENERAL ARRANGEMENT DRAWING		
DRAWING NO. VD-GPIC-MA-3029-3029-0062	REV. 05	SHEET NO. 11 OF 12
		SIZE A1

