

F.A.T.I.

Electric Heaters for Industry



- Process Connection NPT is acceptable.
- one name plate set for each tag to be supplied.
- Certificate 3.1 to be supplied.
- Hydraulic Test is in FATI scope of work.
- Design pressure shall be -1 to 30 barg. please add in the offer
- Design temperature shall be 120 °C

OFFER N° 33710 / 24 / 0

Please check possibility of supply of adaptor 1 1/2" NPT female to 1 1/2" BSPT male, because nozzle connection in oil separator is 1 1/2" BSPT Female.

Dear Sirs,

We thank you for enquiry and are pleased to offer the following quotation as below described.

Quantity:	2
Subject:	Screw connection heater
Heater Item:	30 - OIL HEATER
Power:	2 kW
N° stages:	1 of 2 kW
Voltage:	400V / 3 Ph
Electric connection:	Star
Screw connection:	1 1/2" NPT
Flange material:	St.St. 304
Heating elements:	Active: 3
	Spare: 0
	Sheath Material: SA 249 TP304L
	Diameter: 8,5 mm
Immersed length:	Neutral: 100 mm
	Heating: 600 mm
	Total: 700 mm
Watt density:	2,08 W/cm ²
Heater terminal box:	Waterproof IP 65 Aluminum
Included components:	N: 1 Aut. TG Range 0 - 120 SET 45°C - N: 1 RM-TG SET 120°C
Unit weight:	kg 6,00

Please specify cable input in offer (one cable entry for power, one cable entry for sensors)

Exd IIB T3 IP 65
Aluminum ATEX II2G



www.fati.com
www.fatiheat.com



info@fati.com



+39-02-90119641



Viale A. Volta 52
20047 Cusago (MI) Italy

OFFER N° 33710 / 24 / 0



Commercial Terms & conditions

Enquiry N°	33710 / 24 / 0
Project name	
Subject	ELECTRIC HEATERS
Delivery Time	5 Weeks from order receipt
Delivery Point	EXW Cusago(FATI)
Terms	Incoterms 2020
Payment	To be agreed
Offer Validity	30 days
Warranty	Goods will be guaranteed for 24 months from delivery or 12 months from commissioning whichever is shorter

POS.	Q.ty	Description	Unit price €(euro)	Total price €(euro)
1	2	30 - OIL HEATER	380,00	760,00
2			TOTAL AMOUNT	760,00

INCLUSIONS

- Packing

EXCLUSIONS

- Transportation



www.fati.com
www.fatiheat.com




info@fati.com



+39-02-90119641



Viale A. Volta 52
 20047 Cusago (MI) Italy

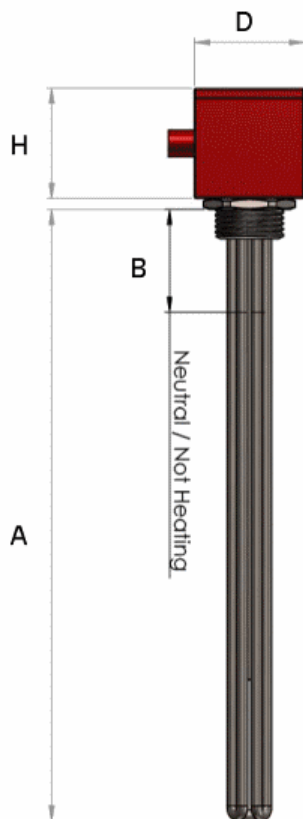

DIMENSIONAL DATA					
A	B	C	D	H	F
700	100		100	80	

PRELIMINARY DRAWING - valid only for bid stage

720

120



CLIENTE CUSTOMER	DELTA GMBH		
PRODOTTO SUBJECT	Screw connection heater kW 2 (30 - OIL HEATER)		
OFFER REFERENCE	33710	REV.	0
DATE	27/05/2024	COMPILED BY	Niccolò Saporiti
APPROVED BY		DWG NO.	